


Mechanical data		Vessel	Jacket	
Design code	ASME VIII div.1 ed. 2007 add.2008 / PED Cat.IV module H1			
Inspection	FIB / Client			
Design pressure Max / Min	3 / FV	10 / -1	-	barg
Design temperature Max / Min	135 / 0	135 / 0	-	°C
Operating pressure Max / Min	2 / -1	2 / -1	-	barg
Operating temperature	120 / 10	120 / 10	-	°C
Test pressure (horz)	4.53	16.3	-	barg
Volume	1.3	see note 15	-	m³
Corrosion allowance	0	0	-	mm
Joint efficiency	0.85 acc. uw 12 (b)	0.85 acc. uw 12 (b)	-	
X-ray	spot acc. uw 11 (b)	spot acc. uw 11 (b)	-	%
Weight empty (incl. 31 Kg. insulation)	615	-	-	Kg
Weight full of water	-	1916	-	Kg
Welding method	See WPS			
Surface treatment	SS	Pickled and passivated		
	CS			
Tolerances according	FIB-TOL-002			
Flange gasket contact face finish	Smooth finish (Ra 3.2-6.3 µm)			
Bolt holes in the flanges to straddle centerlines unless otherwise shown on dwg				

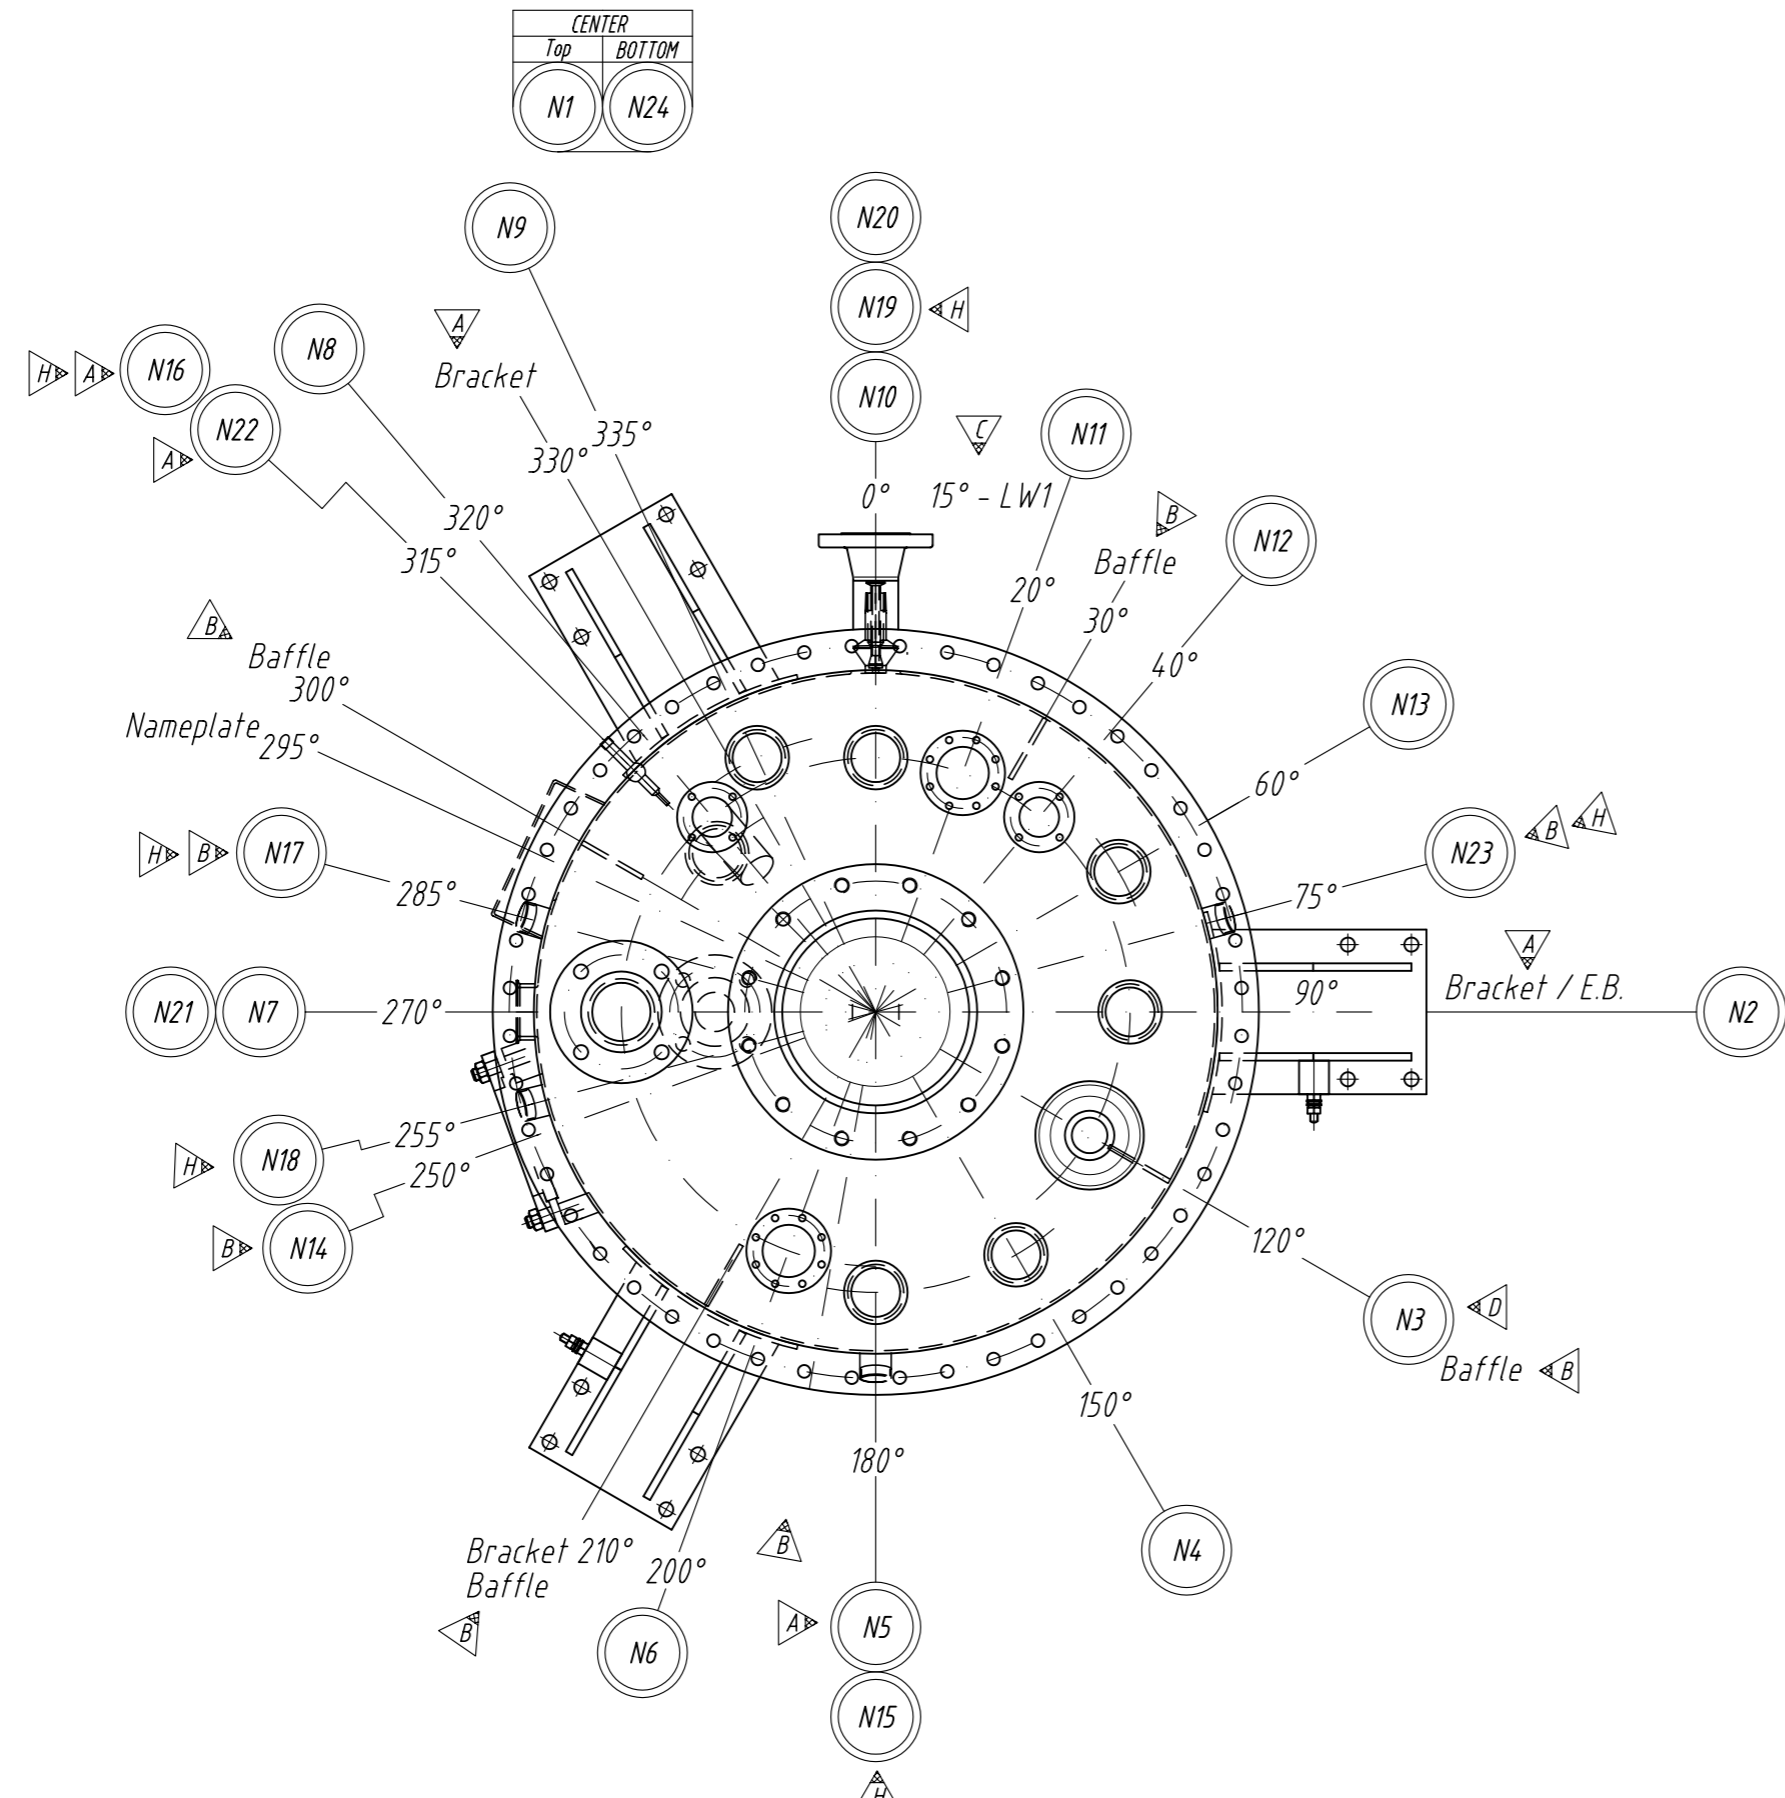


Process connection					
Mark	Numb. Req.	Service	Nom. Bore	Pipe	Flange connection
N1	1	Agitator Connection	DN250	-	PAD Flange PN10 DIN 28117 Aseptic
N2	1	Product inlet	DN50/40	-	Varivent 00-001
N3	1	Antifoam	DN32/25	-	Varivent T housing 221MBL002243G-3
N4	1	Sulphuric Acid	DN50/40	-	Varivent 00-001
N5	1	Spare	DN50/40	-	Varivent 00-001
N6	1	Spraynozzle 1	DN50	60.3x5.13	DIN 11864 aseptic Flange Gea supply
N7	1	Grain Inlet	3"	88.9x5.49	WNFF 150# ASME B16.5
N8	1	Ventilation	DN50	60.3x5.13	DIN 11864 aseptic Flange Gea supply
N9	1	Ammonium hydroxide	DN50/40	-	Varivent 00-001
N10	1	Caustic	DN50/40	-	Varivent 00-001
N11	1	Spraynozzle 2	DN50	60.3x5.13	DIN 11864 aseptic Flange Gea supply
N12	1	Process Air/N2 with dip pipe	DN50	60.3x5.13	DIN 11864 aseptic Flange Gea supply
N13	1	Chemical x	DN50/40	-	Varivent 00-001
N14	1	Sight / Lightglass	DN125	-	DIN 28120 PN10 aseptic 00-015
N15	1	pH transmitter 1	DN25	-	Elcolab Ingold Socket Inclined
N16	1	Temperature	-	-	E&H Weld-in Thermowell
N17	1	pH transmitter 2	DN25	-	Elcolab Ingold Socket Inclined
N18	1	O2 Transmitter 1	DN25	-	Elcolab Ingold Socket Inclined
N19	1	Sample valve	-	-	Keofitt Valve body W9 type T
N20	1	Jacket cooling / heating -	2"	60.3x2.77	WNRF 150# ASME B16.5
N21	1	Jacket cooling / heating +	2"	60.3x2.77	WNRF 150# ASME B16.5
N22	1	Level Switch Bottom	G 1"	-	Special insert acc. E&H (see note 16)
N23	1	O2 Transmitter 2	DN25	-	Elcolab Ingold Socket Inclined
N24	1	Product outlet	DN80/65	-	Varivent T housing 221MBL002243G-3

Other connection					
Mark	Numb. Req.	Service	Nom. Bore	Pipe	Flange connection
N25	3	weight transmitter	-	-	GEA supply

- General notes**
- Build up: Shell, Rockwool & Aluminiumplate.
 - Dimple plate at vesselside, and half coil on bottom
 - All main pressure bearing parts 3.1 cert. EN10204 acc. PED annex 1 Par. 4.3
 - Finish outside, Pickled and passivated
surface finish inside: 2B - Ra: < 0.8 µm
Welding finish inside: Polished Ra: < 0.8 µm
 - Flange N1 "Agitator connection" Machining after welding
 - Nameplate acc.: GIS-46-0101 section 7.11.3
 - Earthingbosses acc.: GIS-46-0101 section 7.11.5
 - All sharp edges inside to be rounded off with R=5
 - For all DIN 11864 nozzles the grooved flange is welded on the vessel.
 - Head weight for lifting: 145 Kg.
 - There are to be no underflush weld caps
 - Only materials from a European or North-American origin will be used
 - 100% DPI of support and lifting attachment welds
 - Refer to aseptic project specification. (BD 2007)
 - V halfcoil = 7.17 Ltr, V dimpleplate = 5.79 Ltr, V total = 12.96 Ltr.
 - Special insert with process conn. for aseptic E&H G 1 "socket, placed in existing shorted Varivent housing

Reference document list		
Document no.	Document name	Client document no.
00-001	Varivent U - Housing 50/40 type Stuts	-
221MBL002243G-3	Varivent T Housing, Flanges	-
00-015	Sightglass DN125	-
15-002	Dimpleplate with halfcoil	-
15-003	Nozzle details	-
15-004	Bracket details	-
15-200	Strength Calculations	-
15-250	WPS	-
15-252	PQR	-
15-298	Risk Analysis	-
15-600	Installation Manual	-
15-900	Test & Inspection plan	-
ZA 7	Process data sheet	-




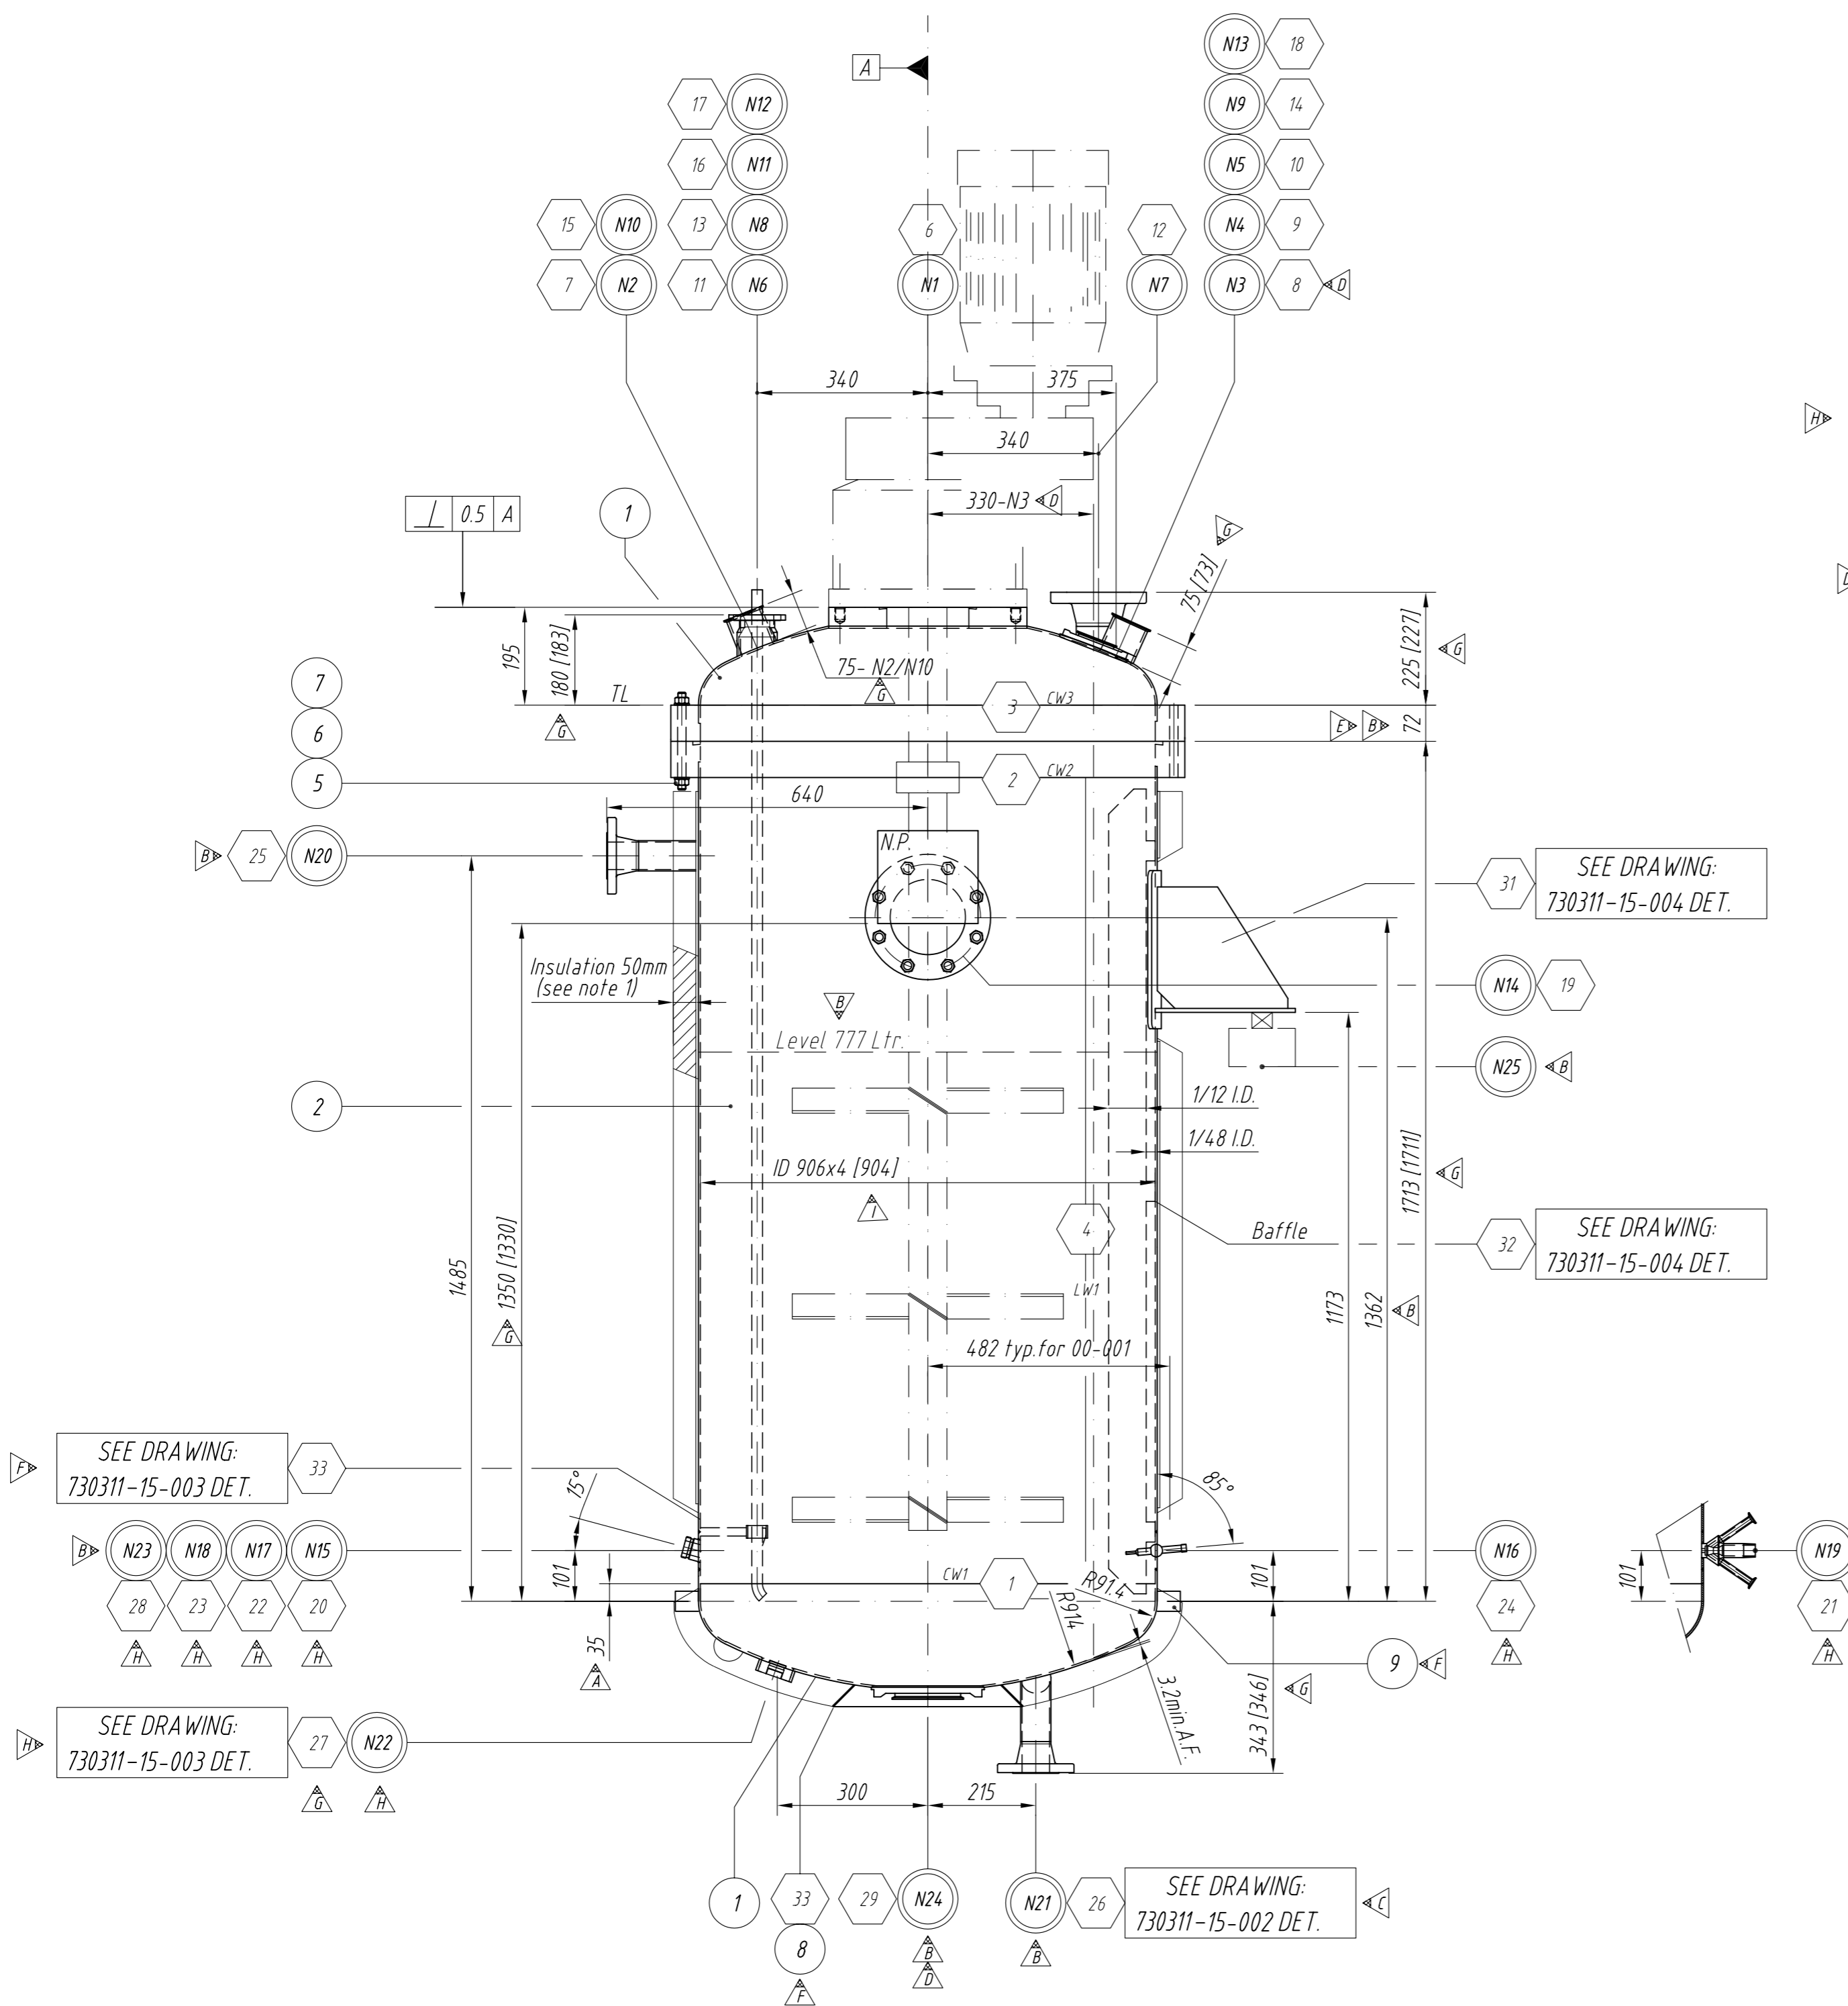


REV.	NO.	DESCRIPTION / DIMENSION	MATERIAL	CERT.
F	9	Plate 4 46x40	A240 316L	3.1
F	8	Plate 2 D=376 d=290 h=42 (Cone)	A240 316L	3.1
E	7	Washer M16 DIN125A	A4	-
E	6	Nut M16 DIN934	A4 DIN267	-
E	5	Studbolt M16x200	A4-70 DIN267	M
F	4	Nameplate 2 180x140	SS	-
D	3	Plate 3 338x160	A240 316L	3.1
B	2	Plate 4 1637x2859	A240 316L	3.1
A	1	Head HD ID=906 t=3.2min A.F.=35 Acc. DIN28011	A240 316L	3.1




AS BUILT STATUS FIB	AS BUILT STATUS CLIENT	AS BUILT STATUS INSP. AUTHORITY
E	F	G
H	I	J
SCALE: 1:10		
DATE: 19-05-2009		
REMARKS: Drawing acc. GEA datasheet YA-V3301 Rev. 1		
DRAWN: A.Hoekstra		
CHECKED: G.Bijl		
PROJECT: GEA Process Engineering Nederland BV		
SUBJECT: BP - ZA 7067 - D15141		
FORM: A1		
SHEET NO: 15-001		

Document no.	Document name	Client document no.
15-975	Welding Document Dimple Plates	-
15-976	Strength Calculations Dimple Plates	-

Reference document list

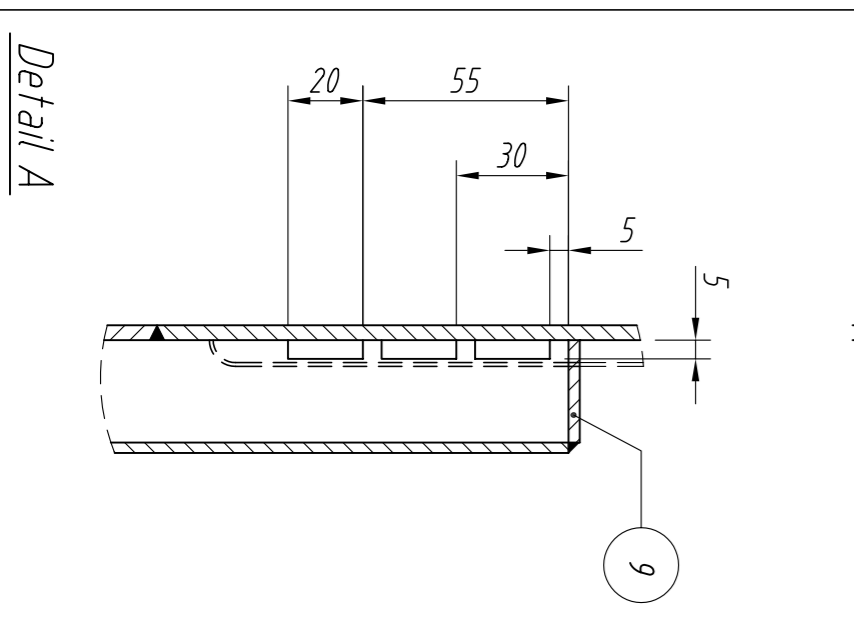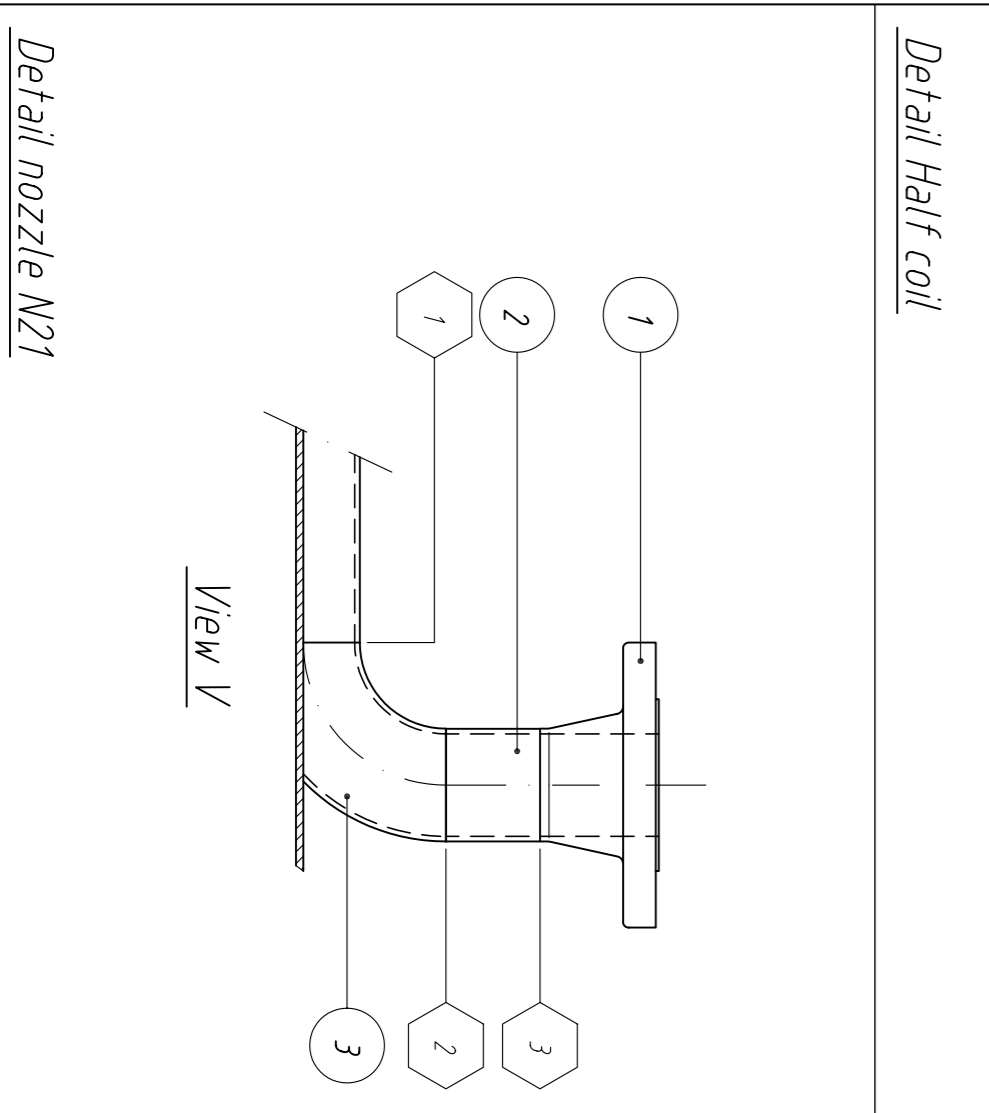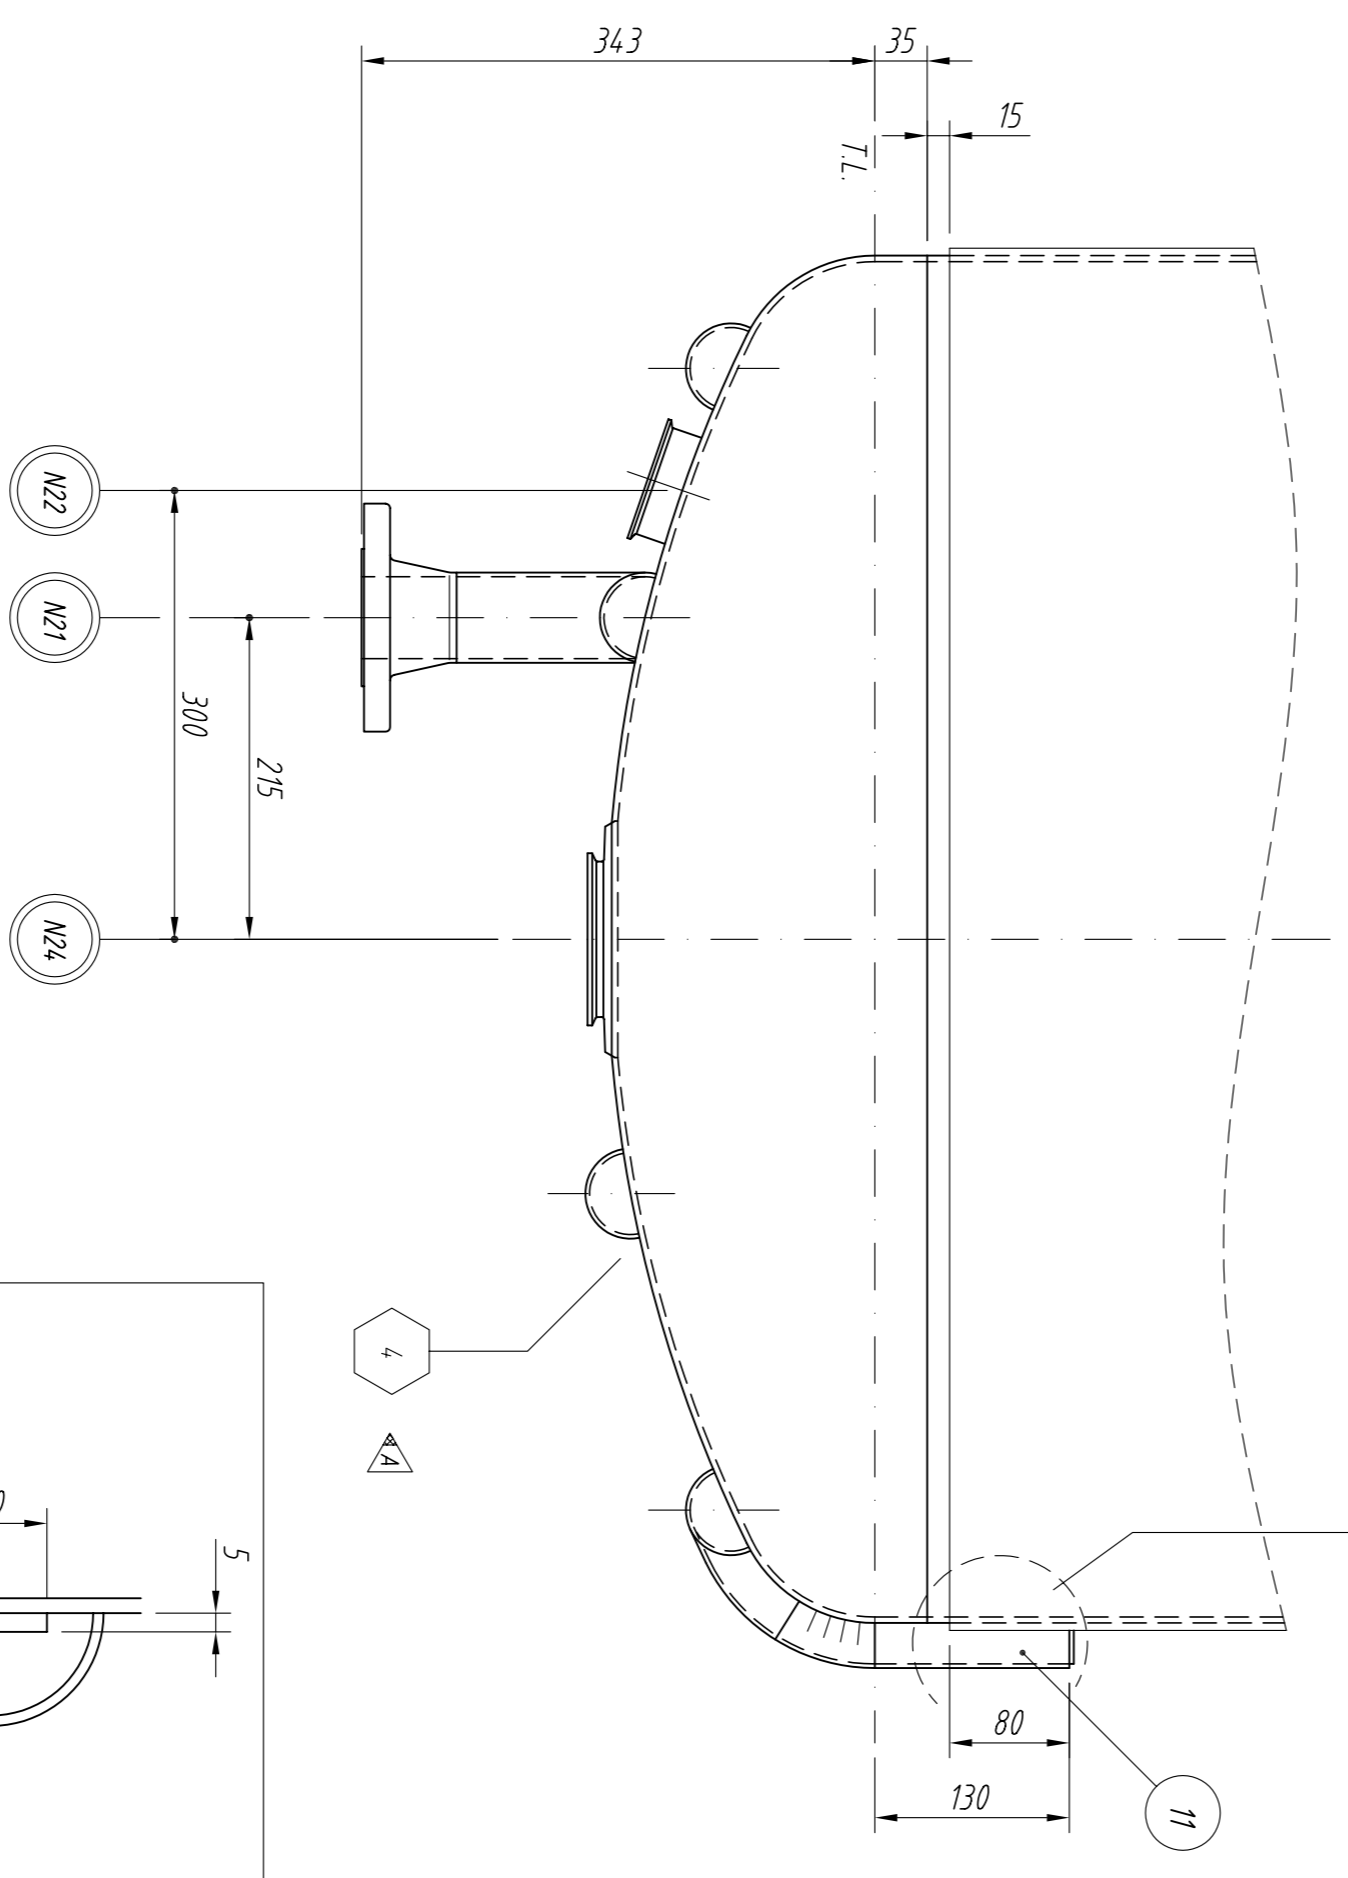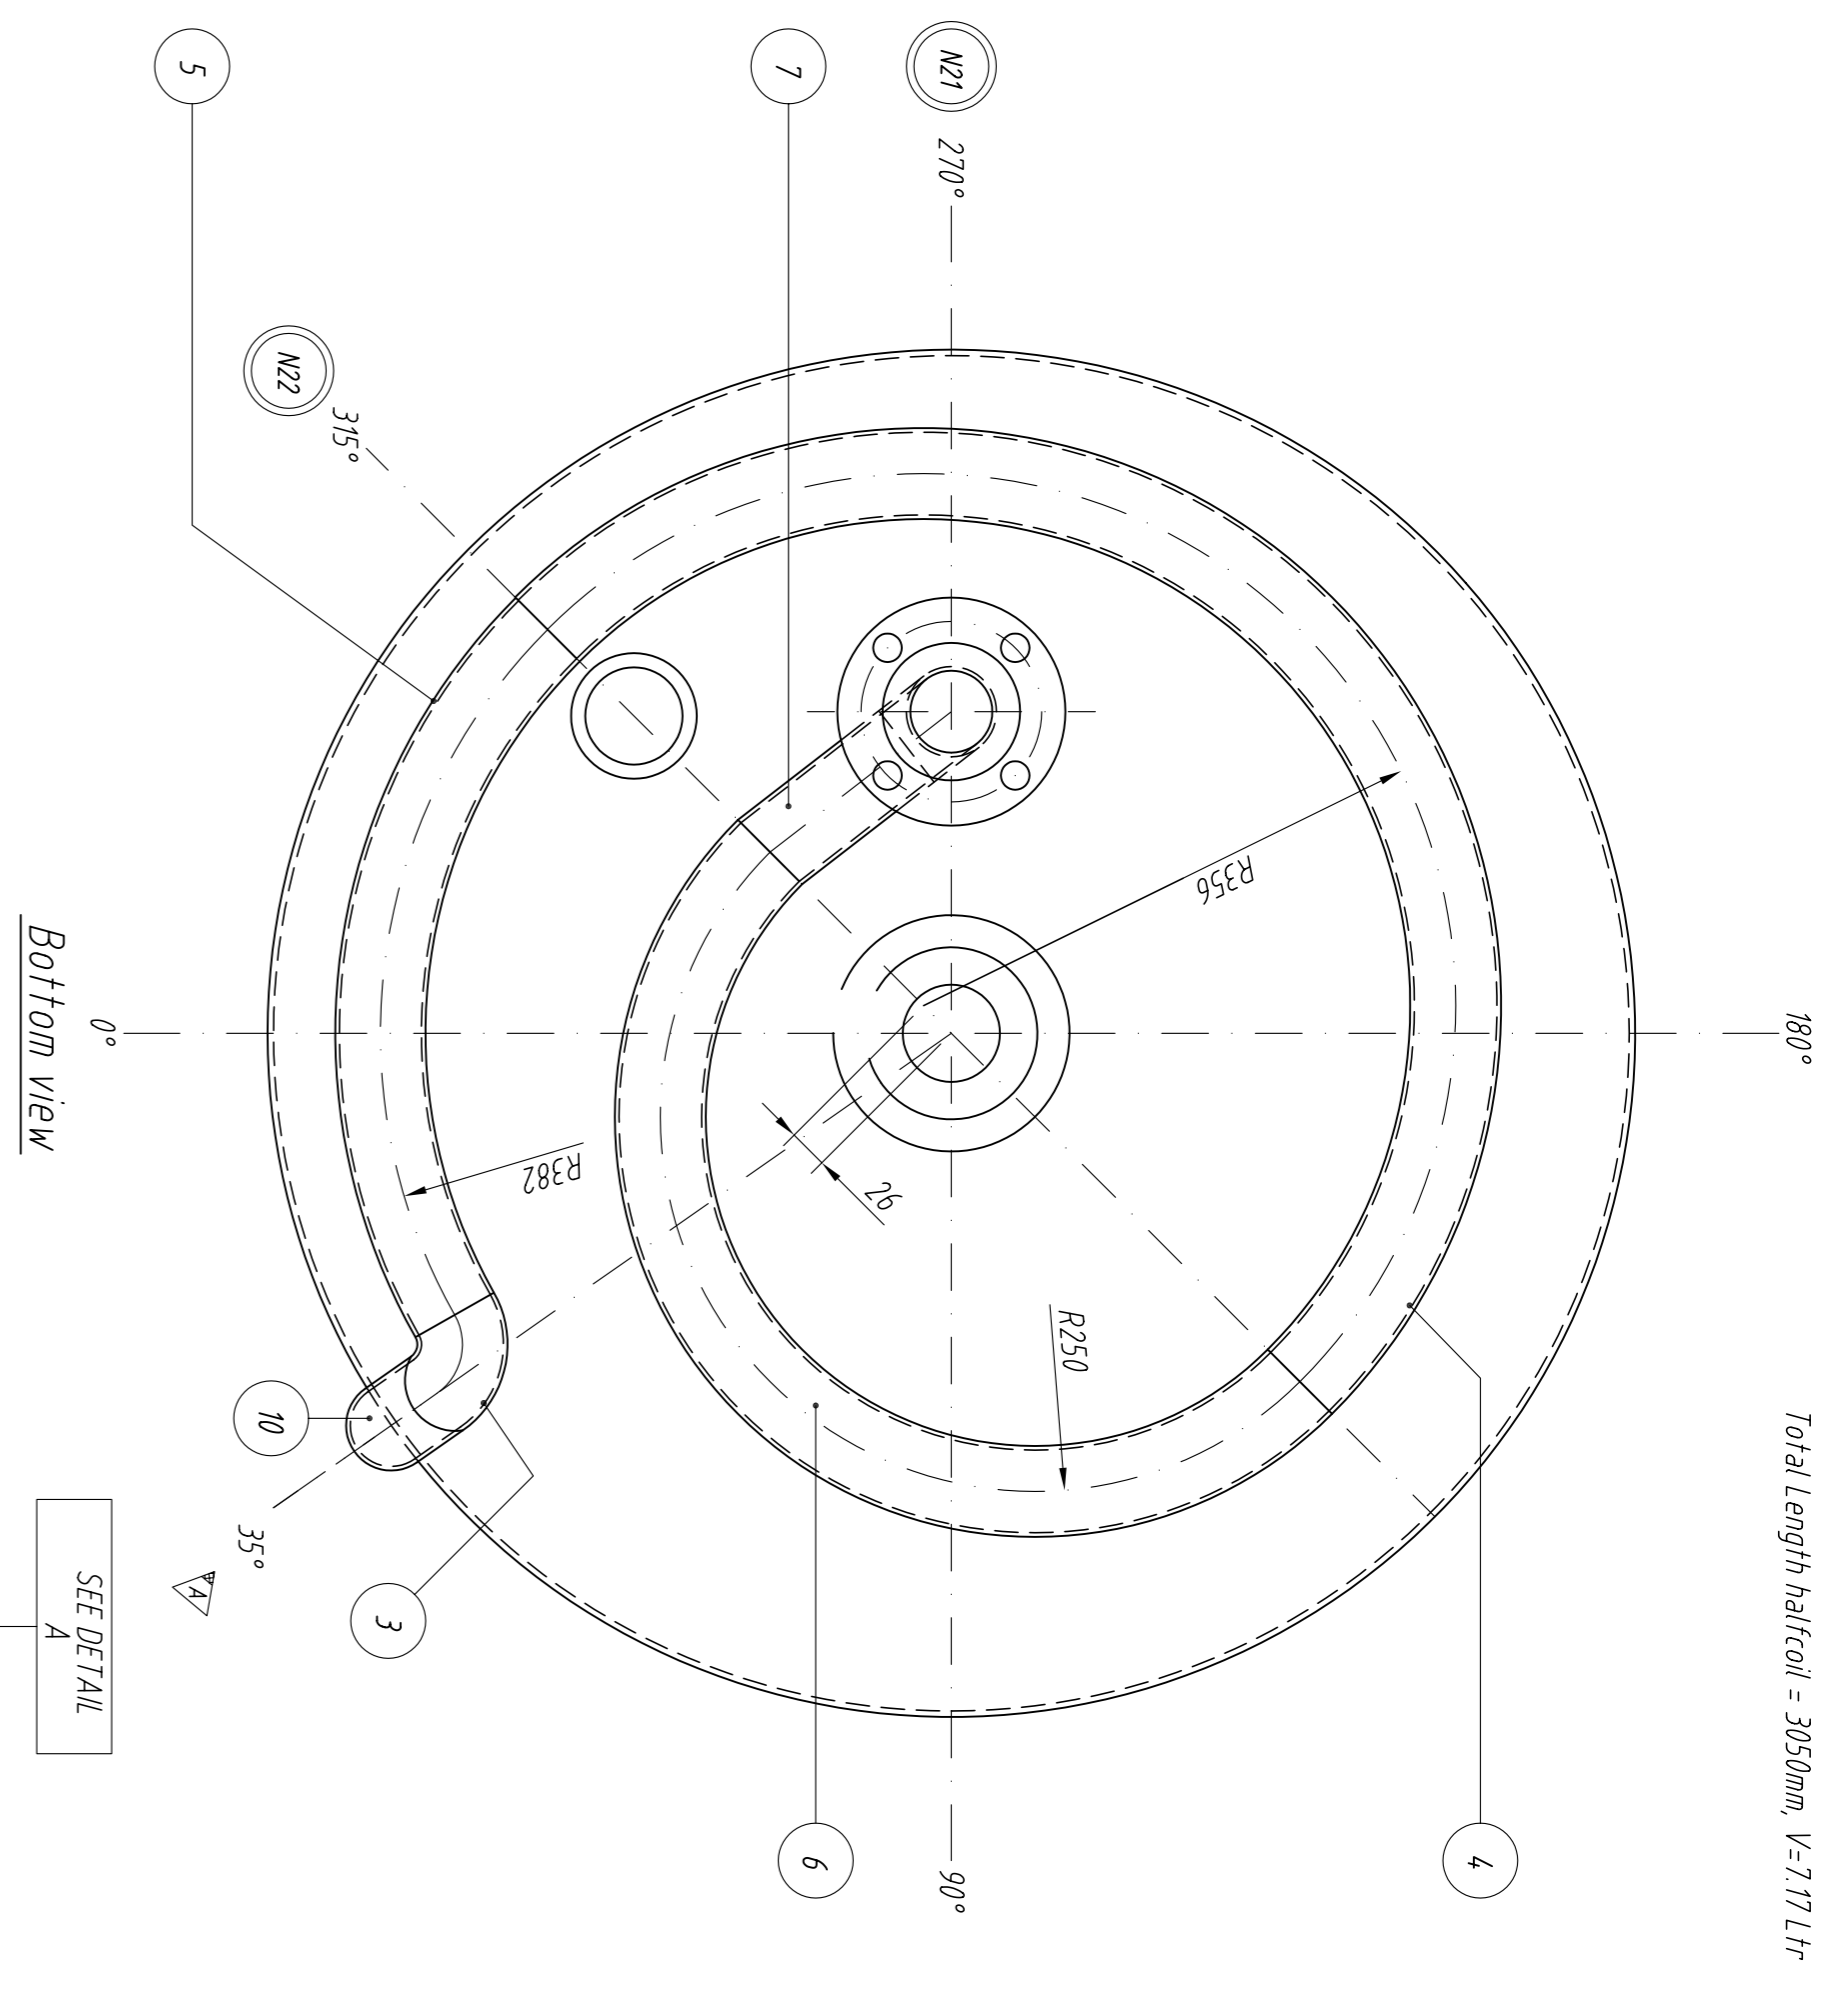

Detail Dimple plate

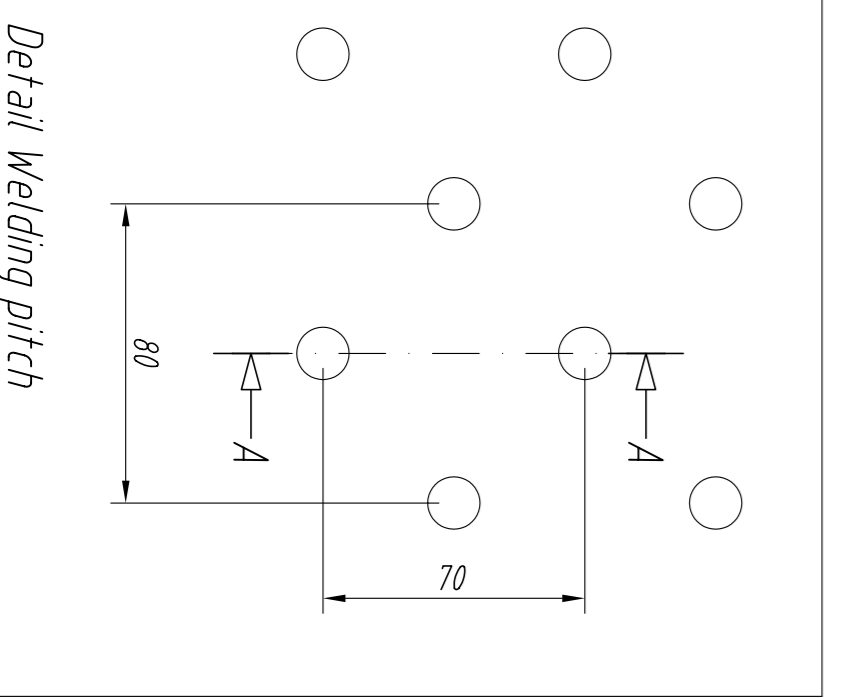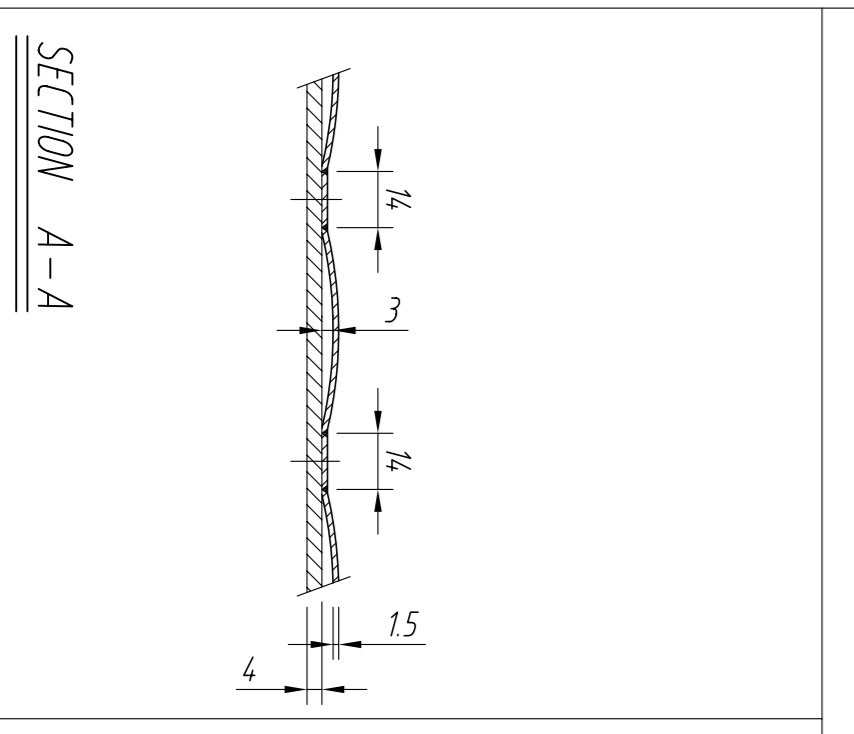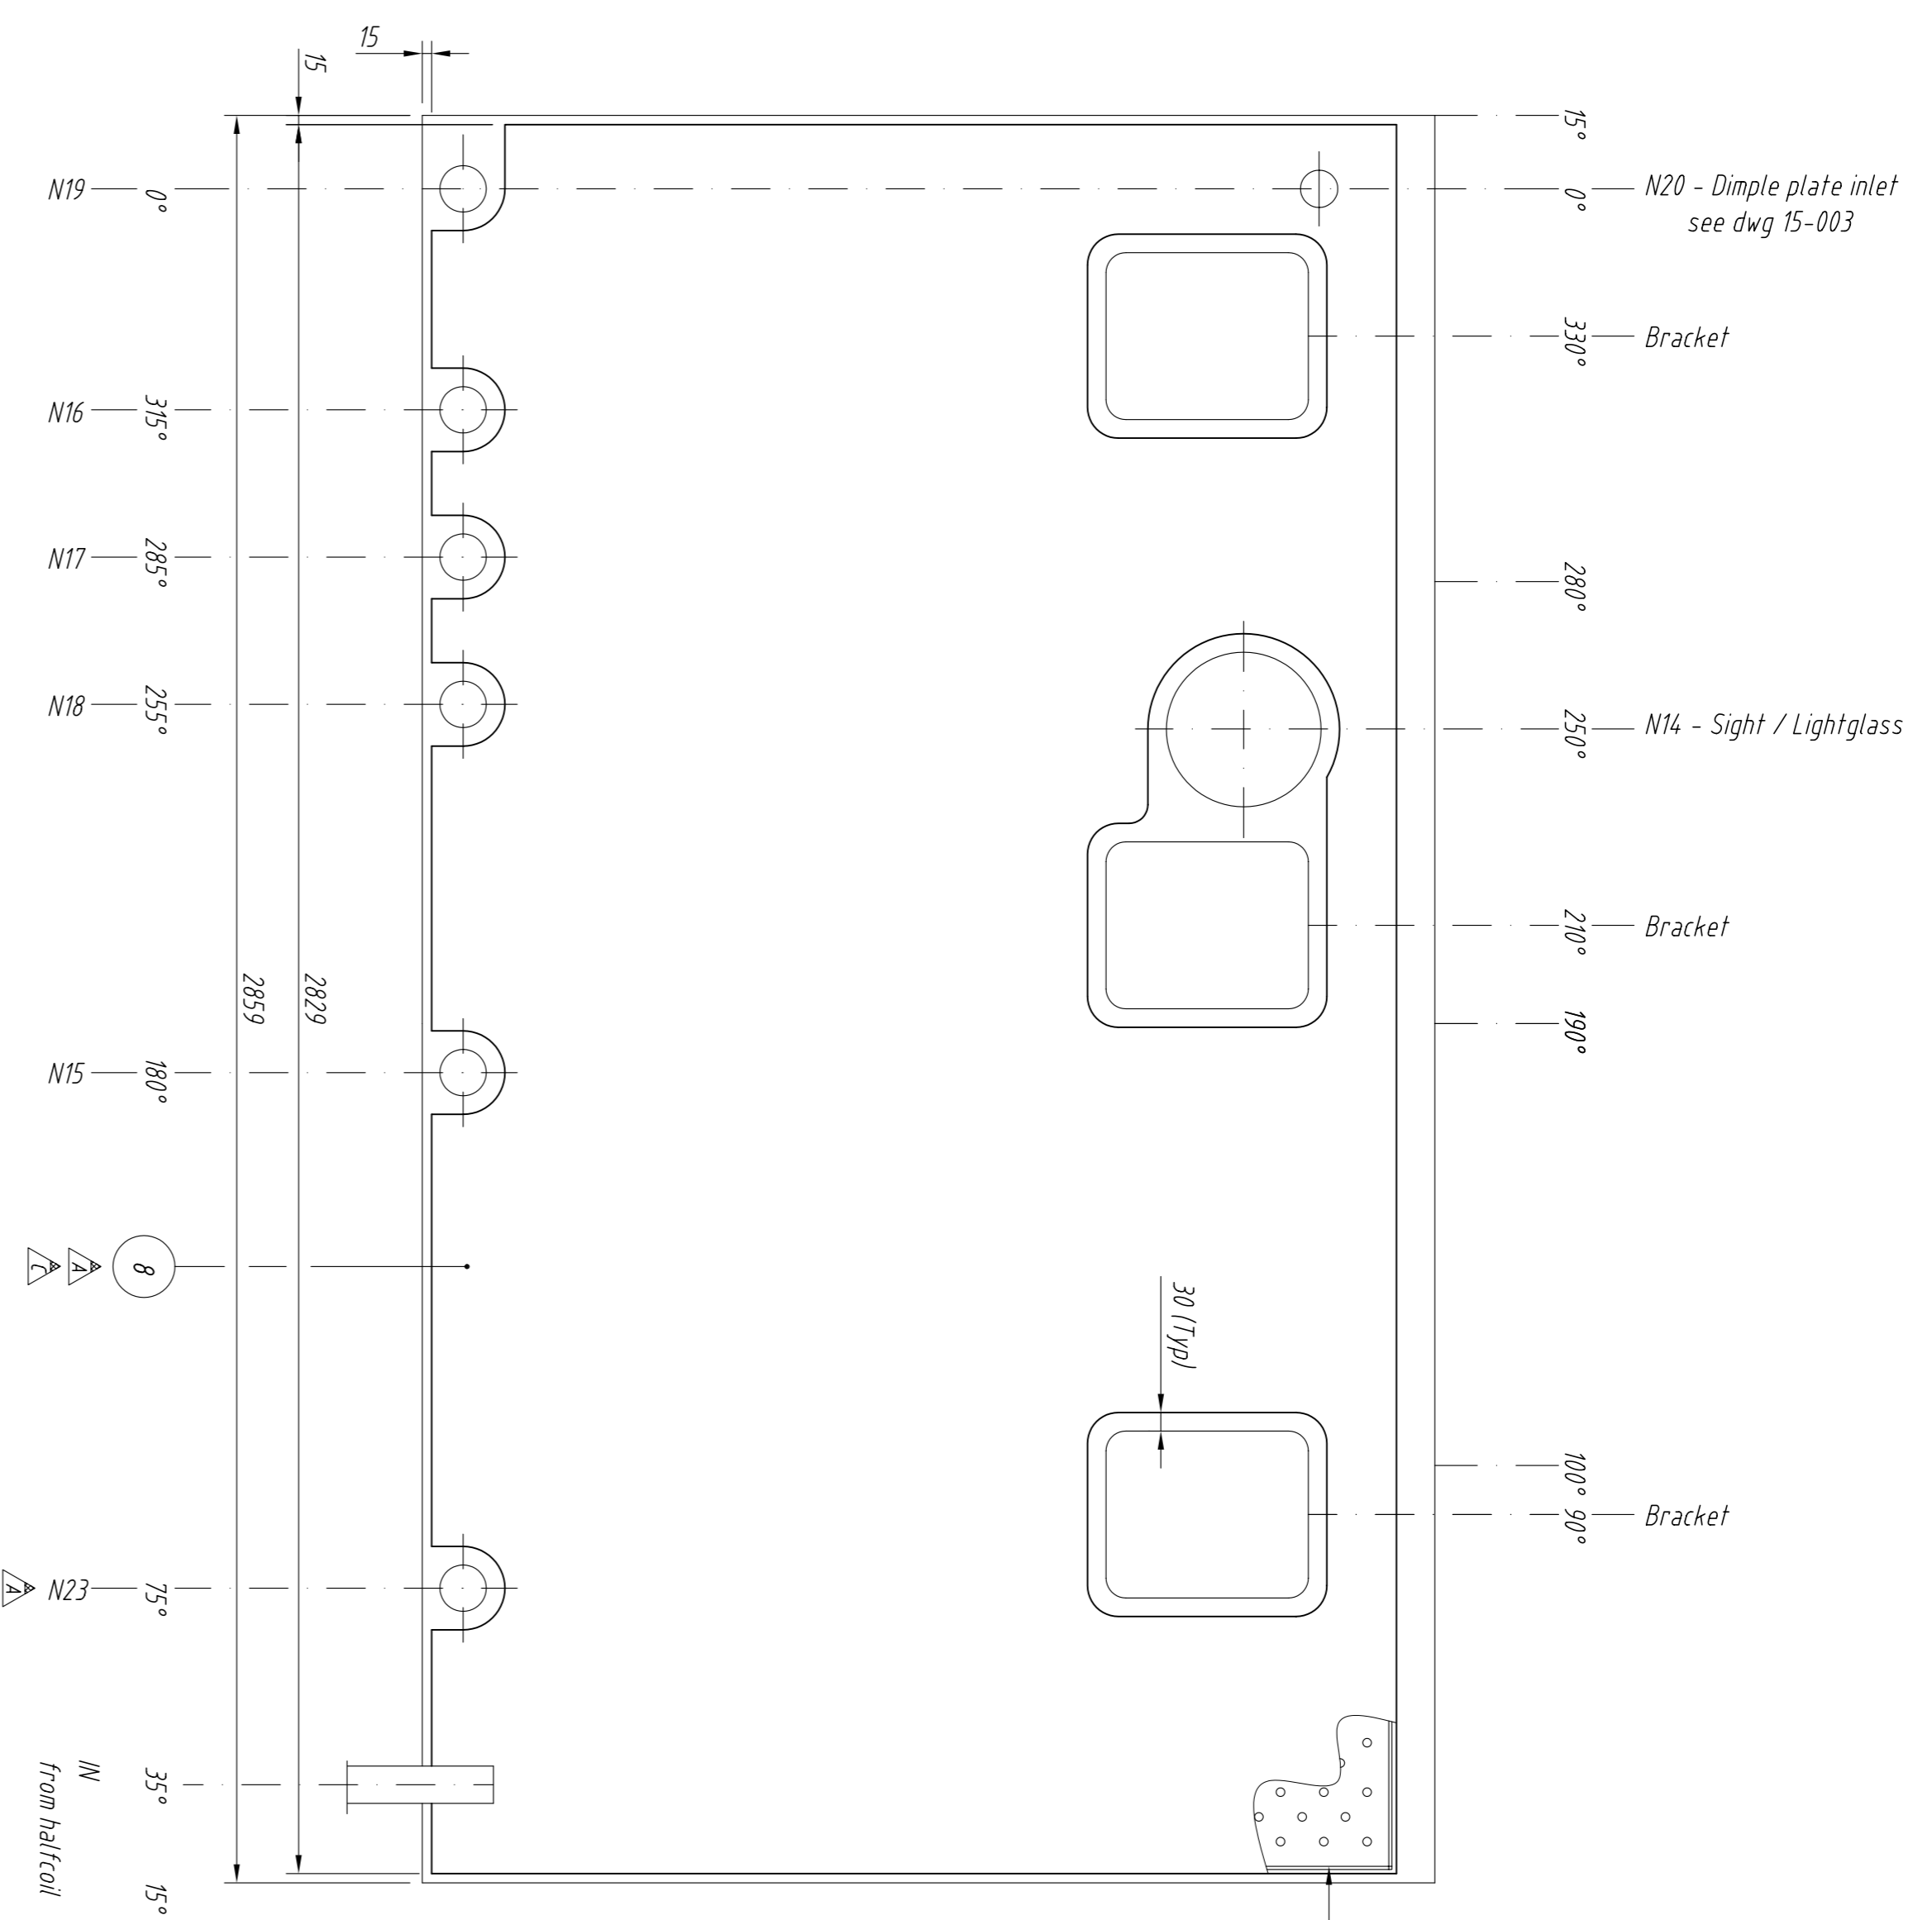

NO.	DESCRIPTION / DIMENSION	AS BUILT	STATUS	CLIENT	AS BUILT	STATUS	MSRP	AUTHORITY
A 1	Halfcoil Ø0.3x2.77L=4.330	A312TP304L						31
A 10	Halfcoil Ø0.3x2.77L=4.850	A312TP304L						31
9	Plate 3 55x27	A240 304L						31
C 8	Dimple plate 15 2829x550	A240 304L						31
A 7	Halfcoil Ø0.3x2.77L=9.6	A312TP304L						31
A 6	Halfcoil Ø0.3x2.77L=790 R=250	A312TP304L						31
A 5	Halfcoil Ø0.3x2.77L=500 R=382	A312TP304L						31
A 4	Halfcoil Ø0.3x2.77L=1020 R=356	A312TP304L						31
A 3	Elbow D=Ø0.33x2.77 90° LR	A40DW304L						31
2	Pipe Welded D=Ø0.33x2.77L=50	A312TP304L						31
1	WMP Flange 2" 150# ASME B16.5 s=2.77 sm fm	A82P304L						31

SCALE	1:10	DATE	29-07-2009	REVISIONS	DATE	REVISIONS
DRAWN	A. Hoekstra	29-07-2009	-			
CHECKED	G. Blyker	20-01-2010	-			

PROJECT: GFA Process Engineering Nederland BV
BP - ZA 7067 - D15141
Medium Seed Fermentor YA - V3301
Dimpleplate with halfcoil

REVISIONS:
A AH, 18-09-2009, see rev. marks.
B AH, 16-10-2009, see rev. marks.
C AH, 13-11-2009, see rev. marks.
D AH, 16-11-2009, see rev. marks.
E AH, 20-01-2010, see rev. marks.

NO.	DESCRIPTION / DIMENSION	AS BUILT	STATUS	CLIENT	AS BUILT	STATUS	MSRP	AUTHORITY
A 1	Halfcoil Ø0.3x2.77L=4.330	A312TP304L						31
A 10	Halfcoil Ø0.3x2.77L=4.850	A312TP304L						31
9	Plate 3 55x27	A240 304L						31
C 8	Dimple plate 15 2829x550	A240 304L						31
A 7	Halfcoil Ø0.3x2.77L=9.6	A312TP304L						31
A 6	Halfcoil Ø0.3x2.77L=790 R=250	A312TP304L						31
A 5	Halfcoil Ø0.3x2.77L=500 R=382	A312TP304L						

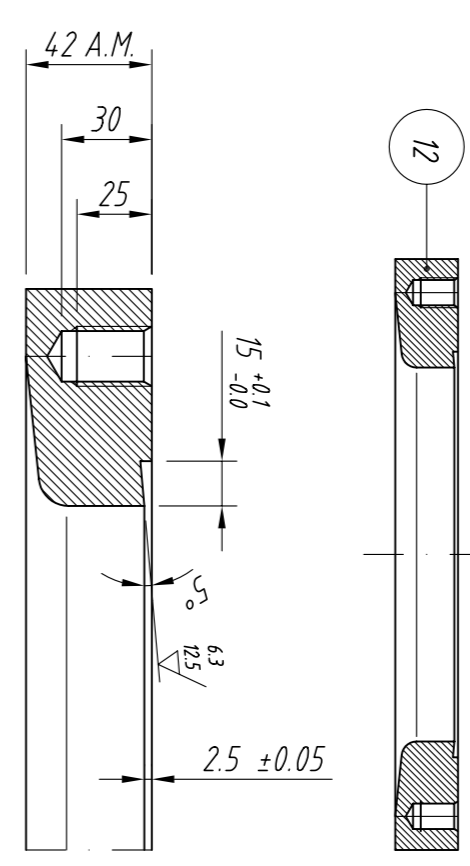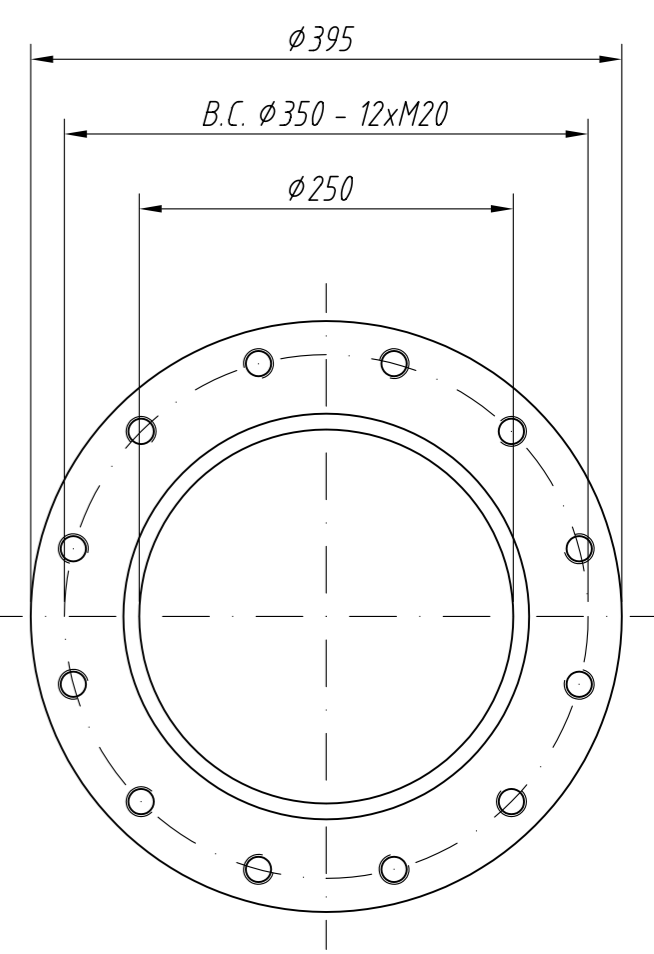



Detail Nozzle N1
acc. DIN 2527 / DIN 250 PN 10

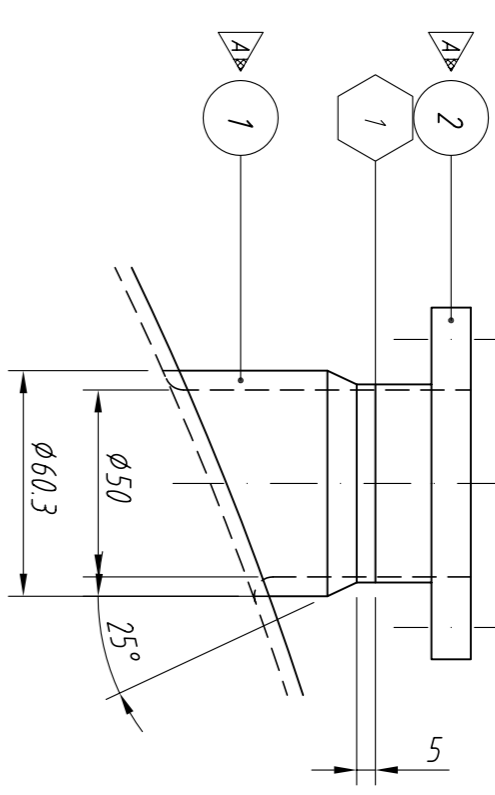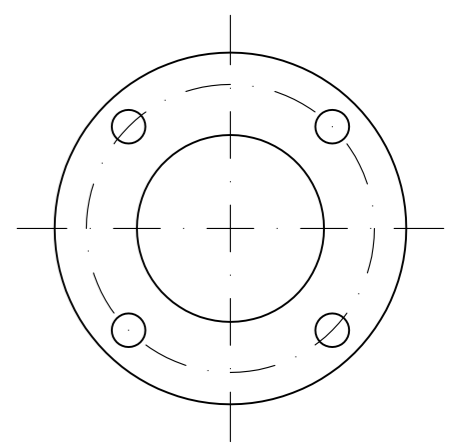



Detail Nozzle N6

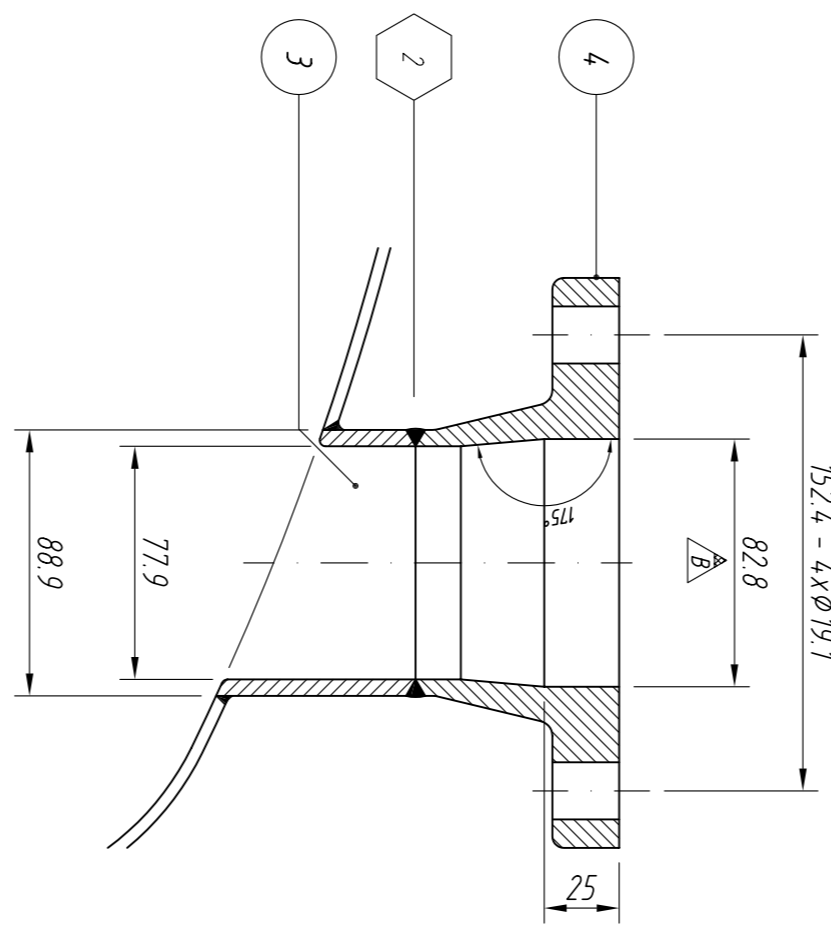


Detail Nozzle N7

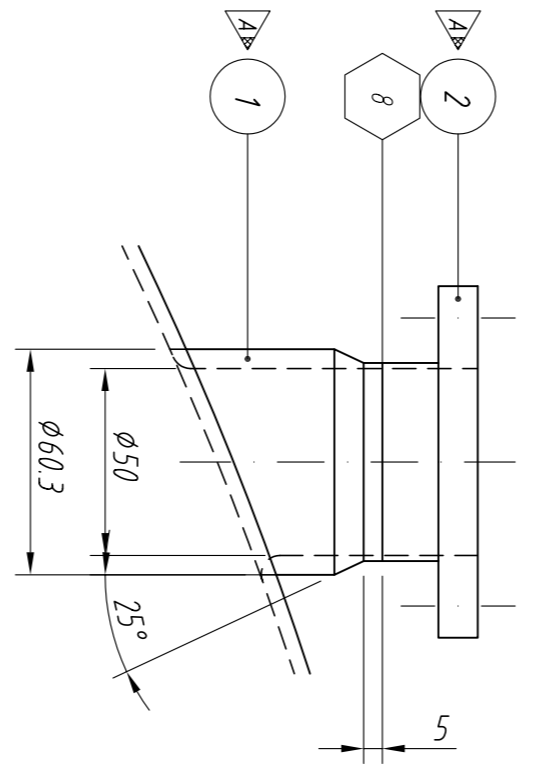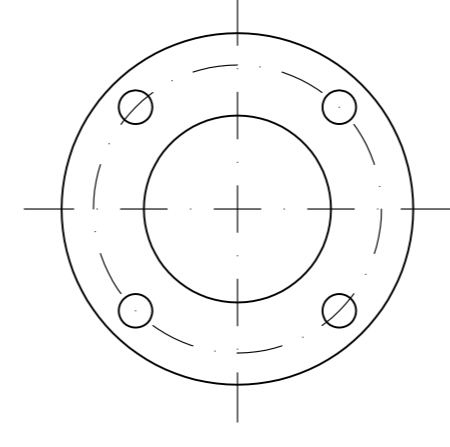


Detail Nozzle N8

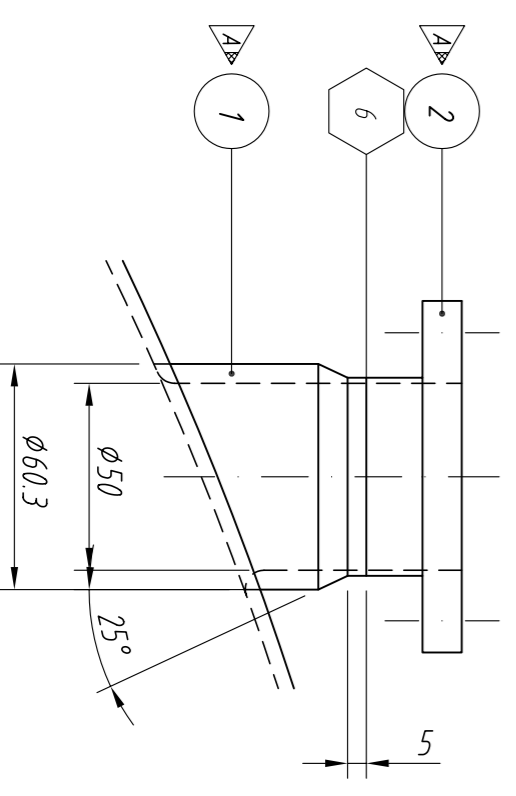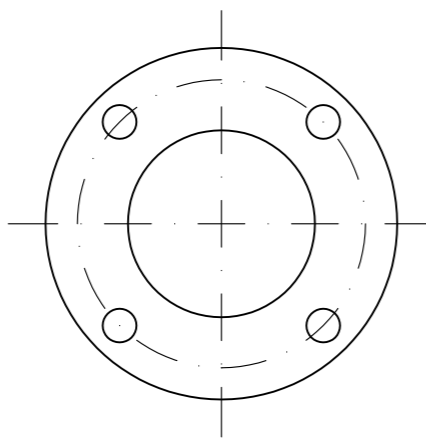

Detail Nozzle N11


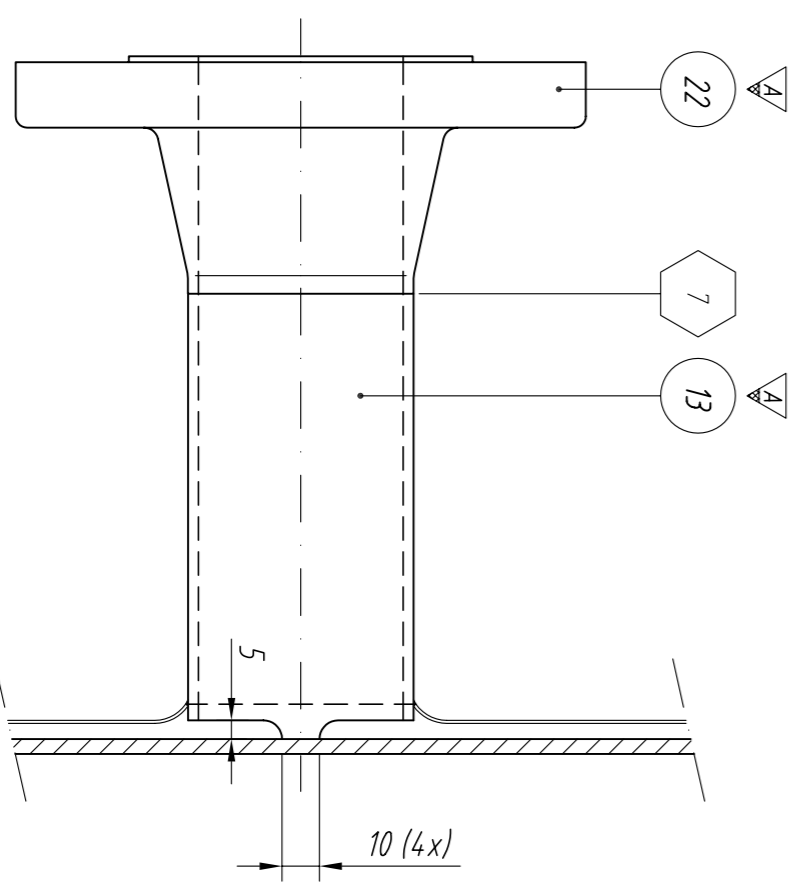


Detail Nozzle N20

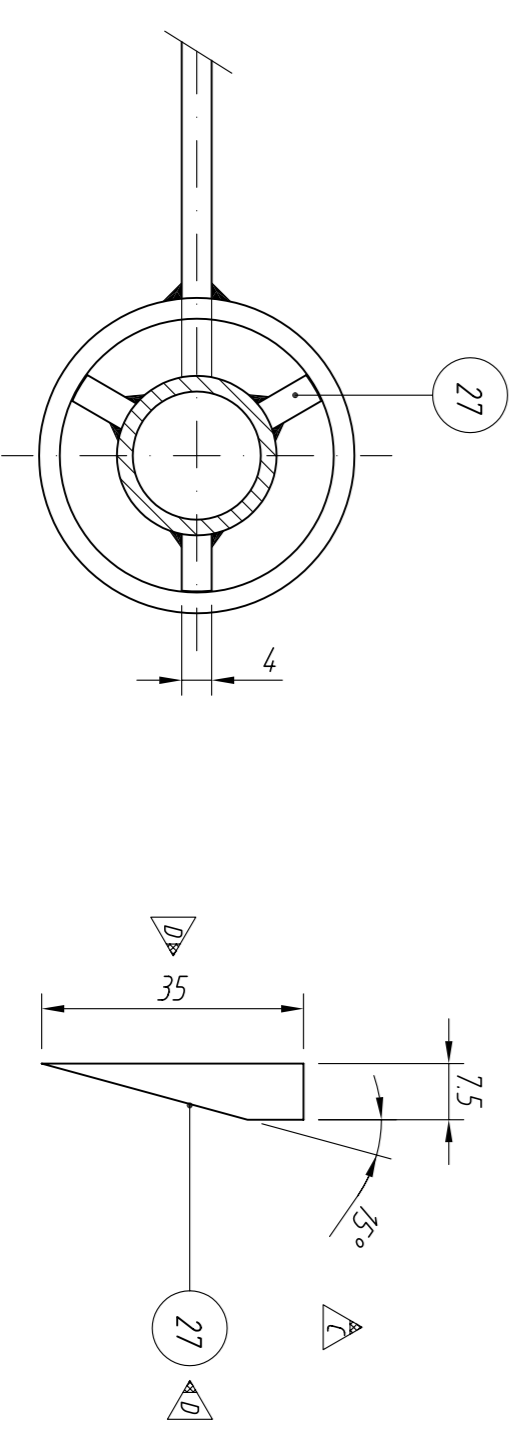


SECTION B-B


Detail Nozzle N12

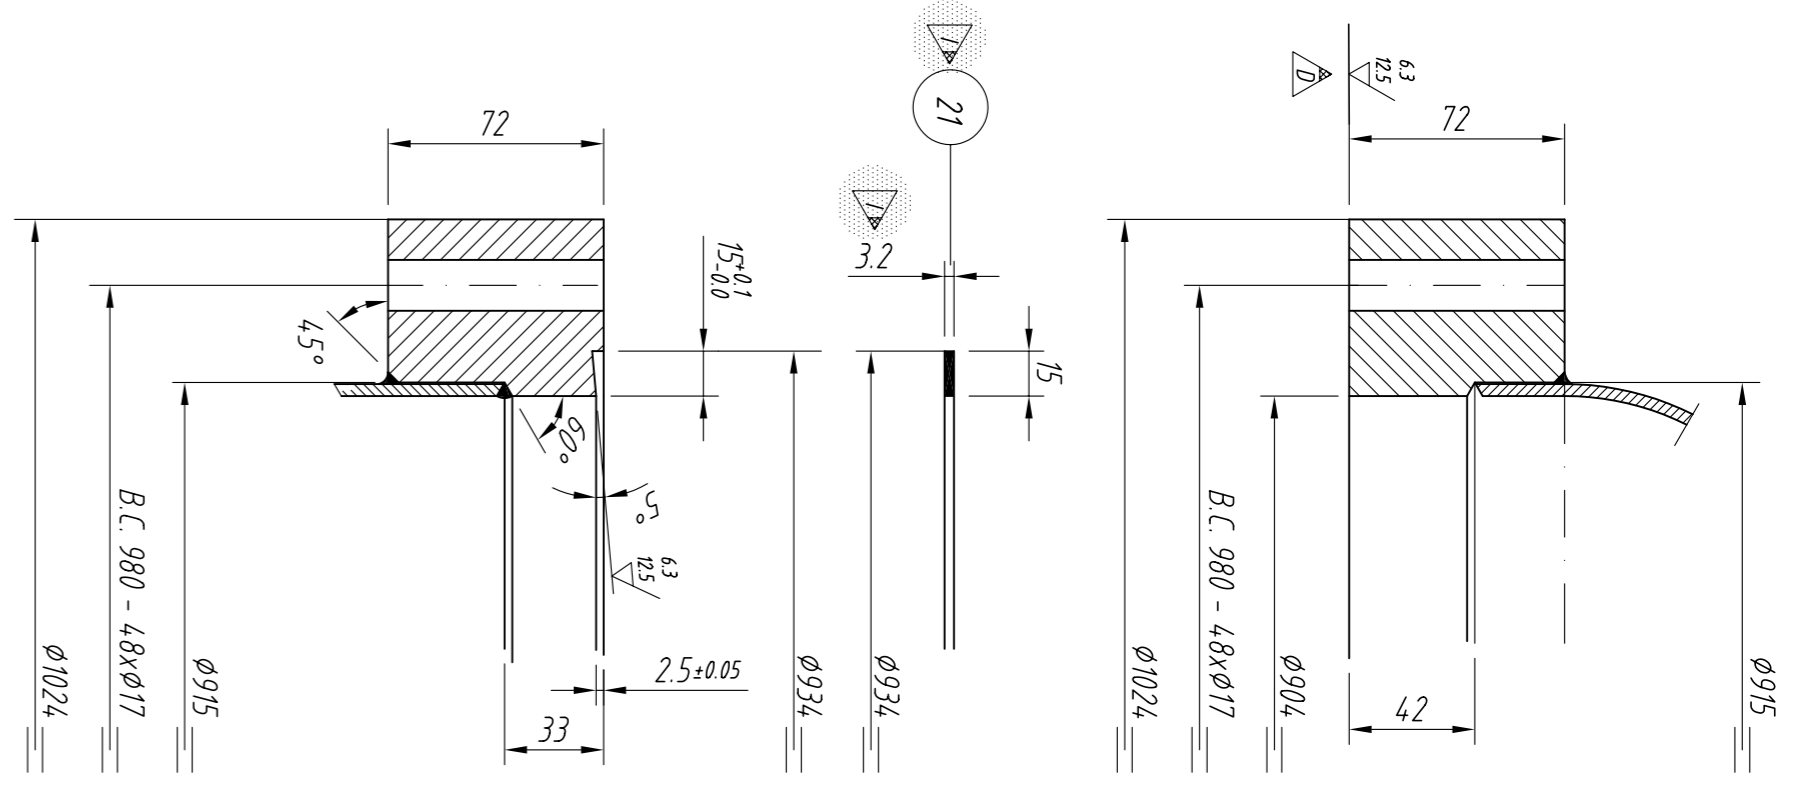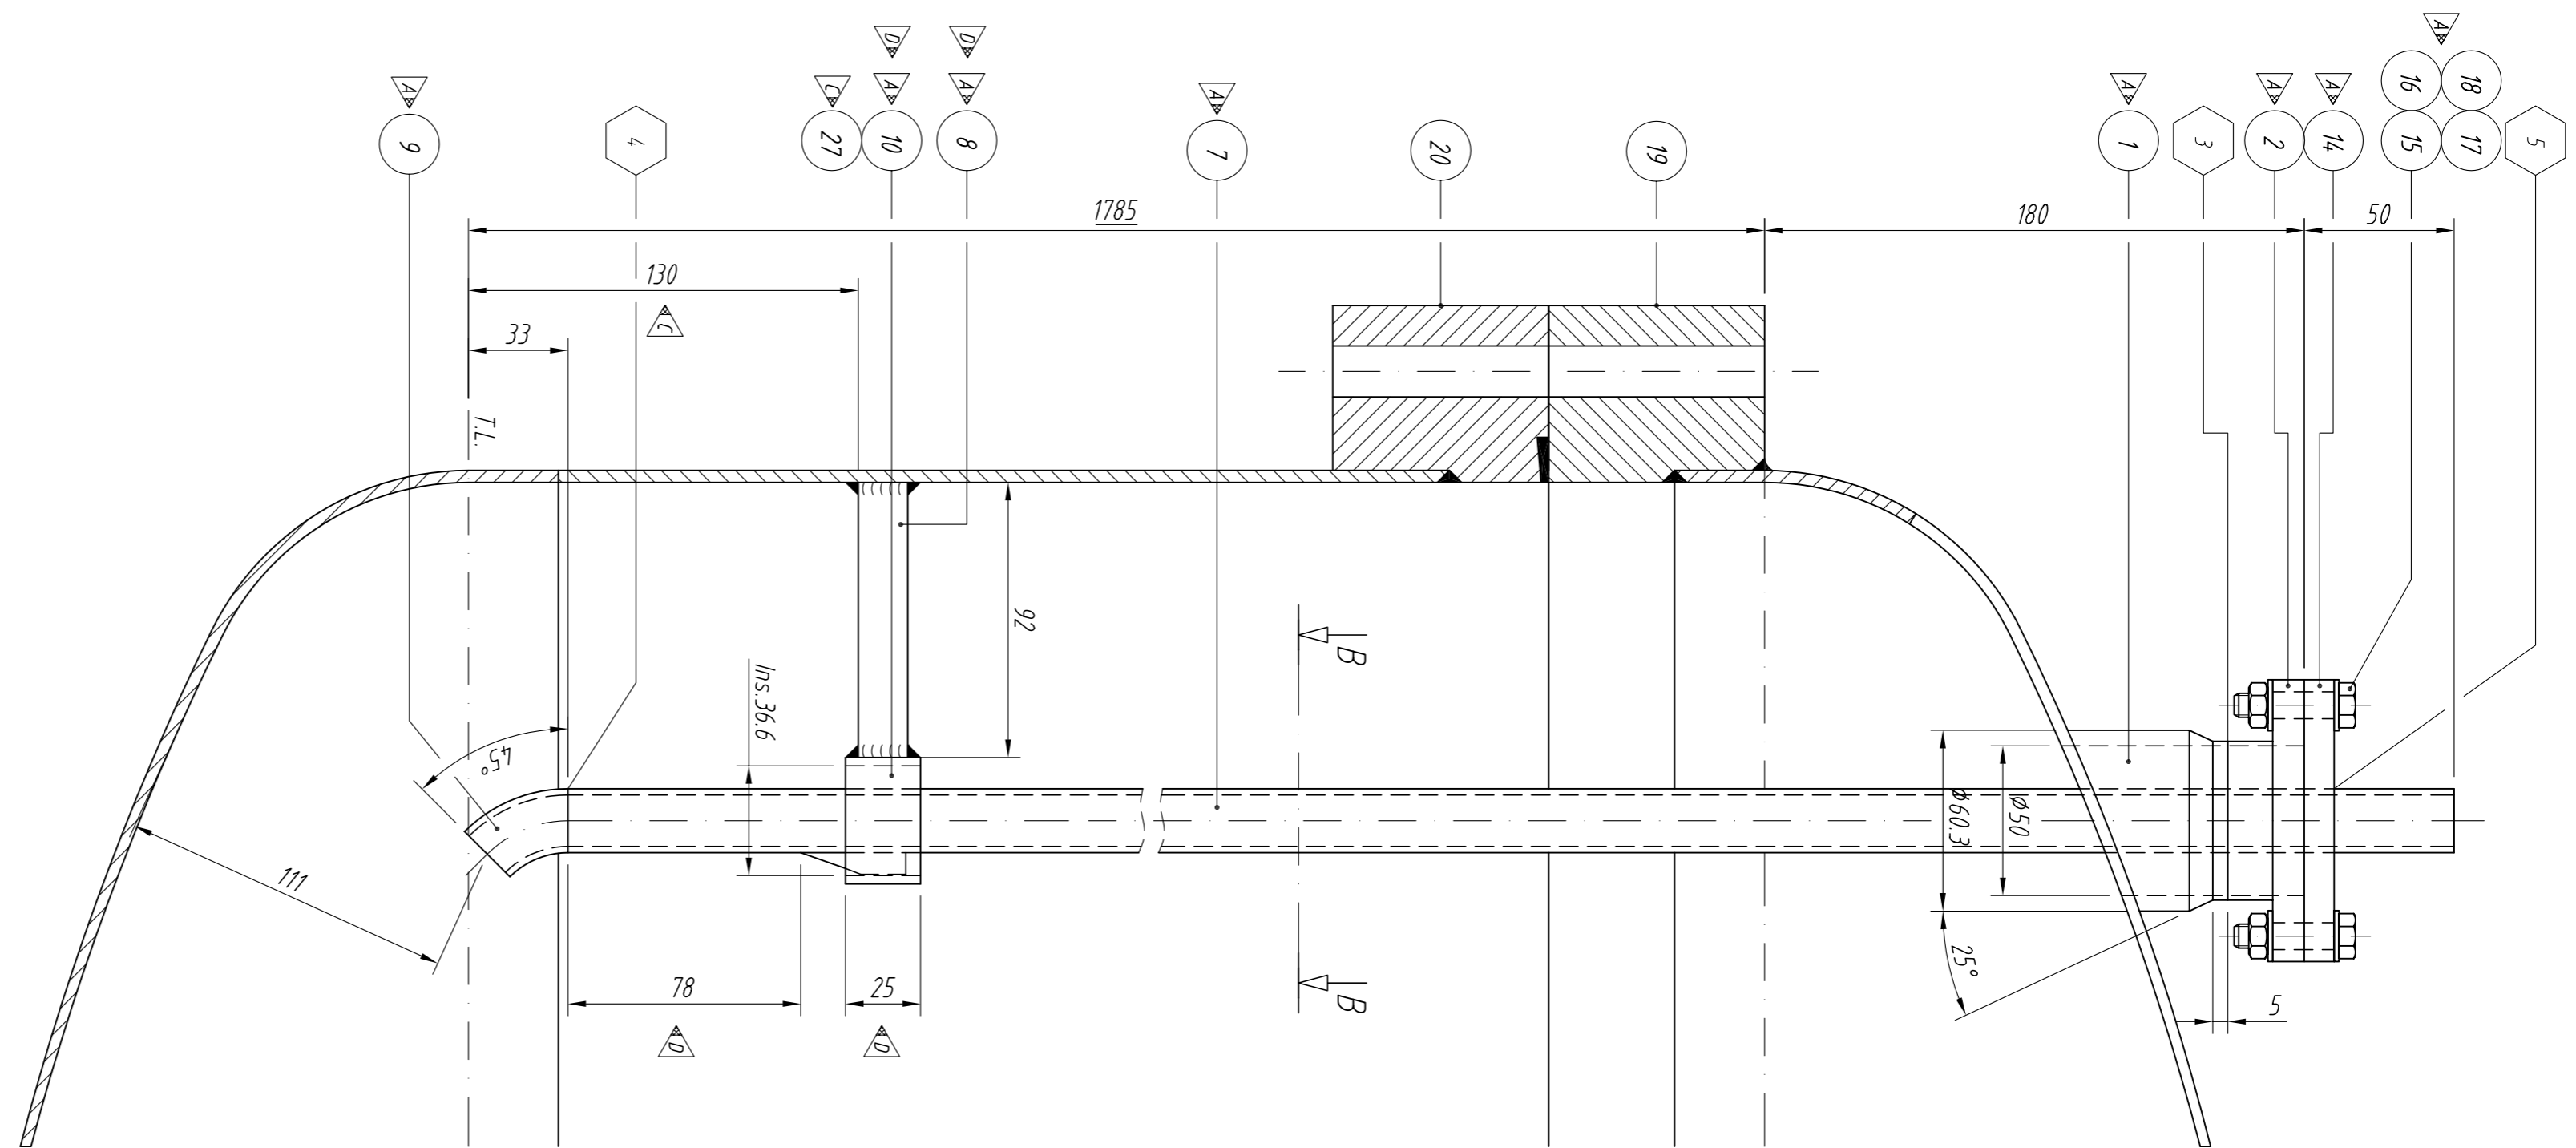


Detail Shell Flange

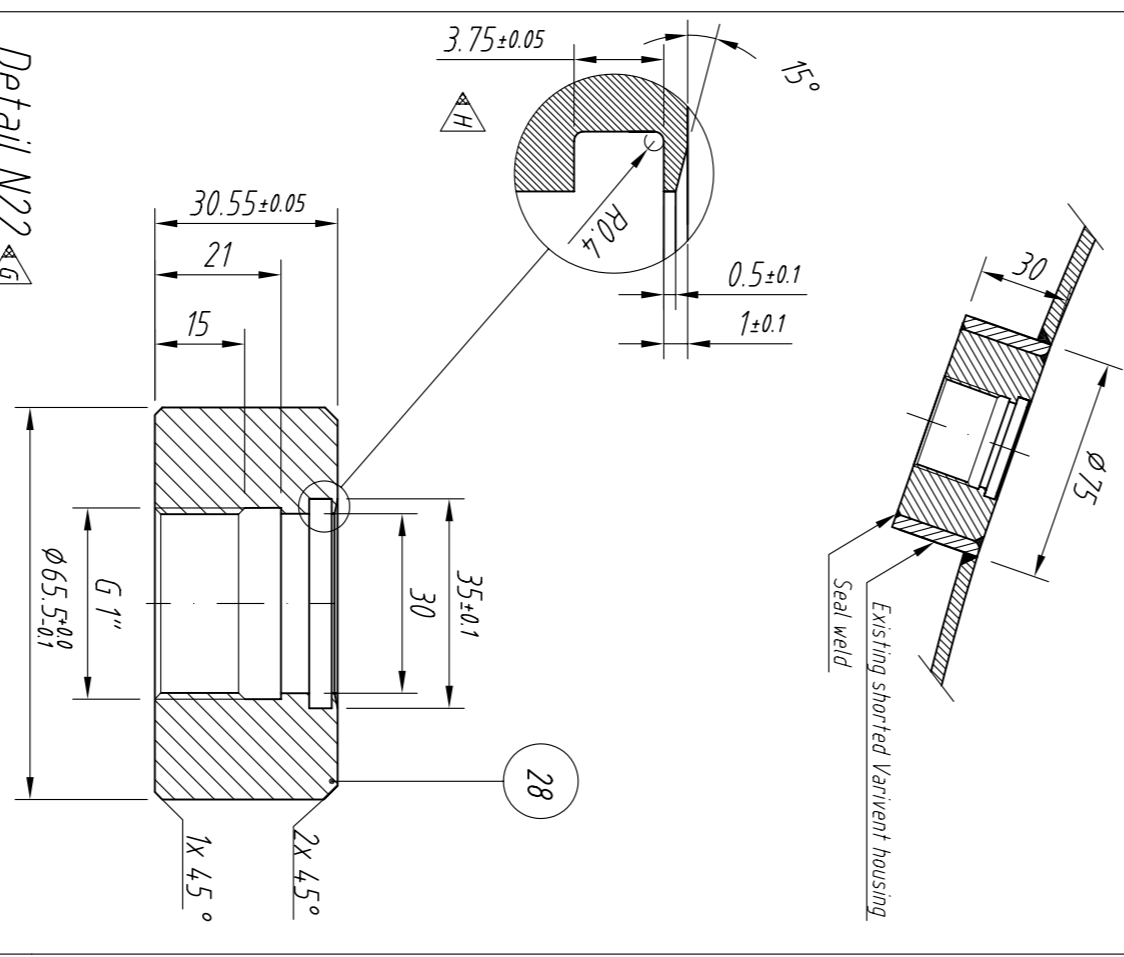


Detail N22

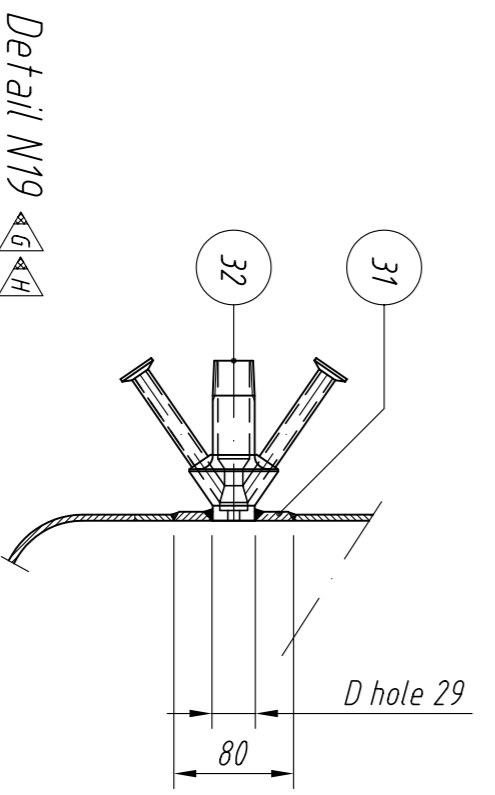

Detail N19

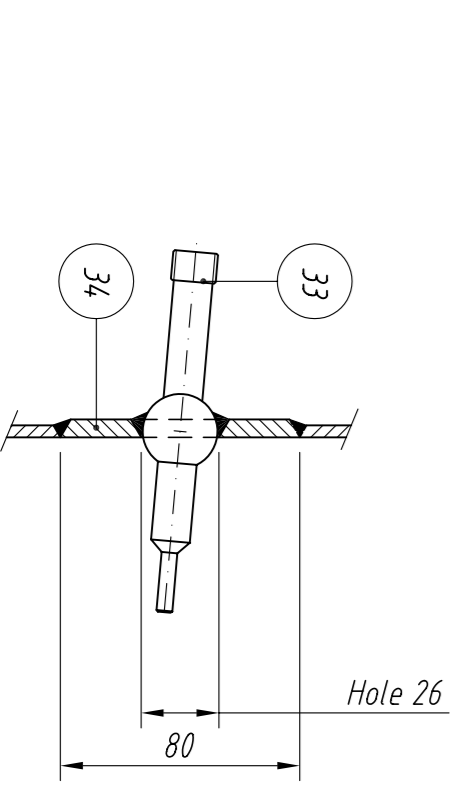

Detail N16

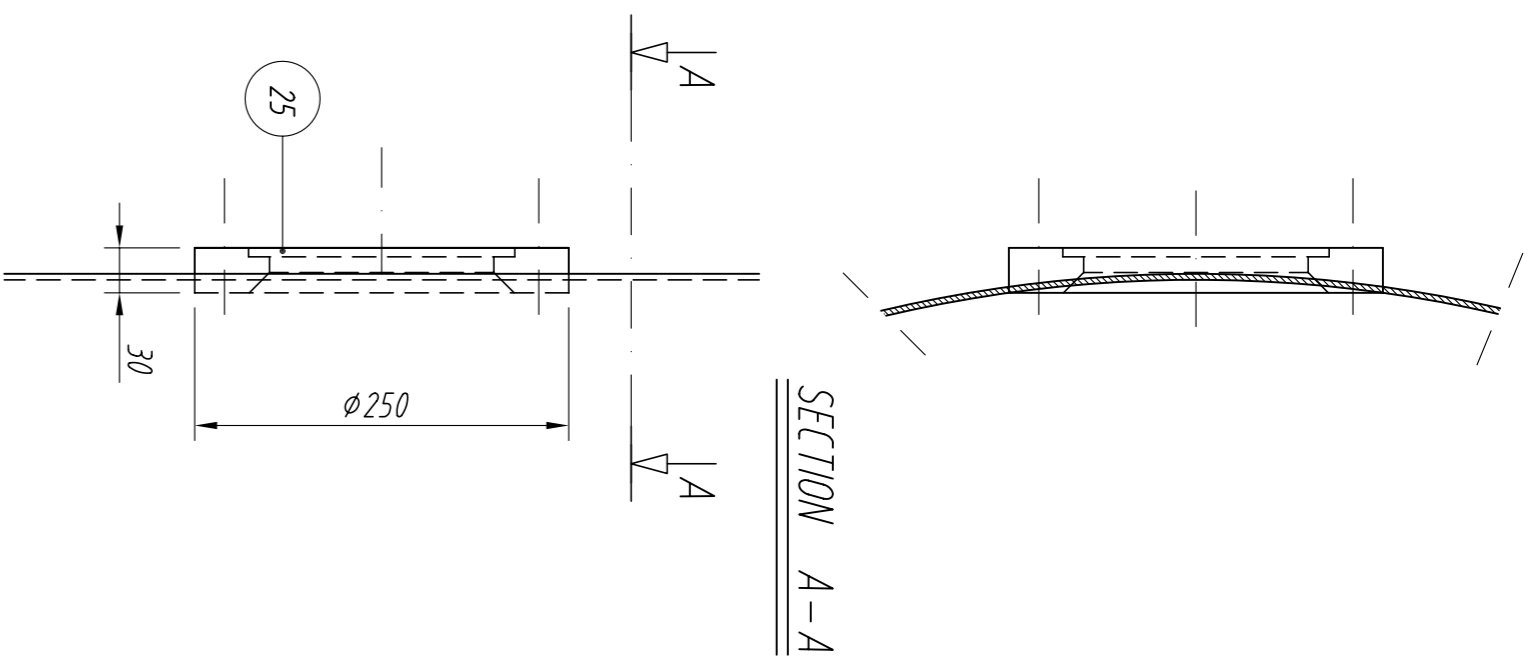

SECTION A-A

Detail N14

NO.	DESCRIPTION	QTY	UNIT	REVISION
H 34	1	Plate 6 D=80x4=26	A240 3R6L	31
H 33	1	ExH Weld-in Thermowell Ø25	A4179 3R6L	31
G 32	1	Sample nozzle Keuffler Valve body W9 type T	A4179 3R6L	31
H 31	1	Plate 6 D=80x4=29	A240 3R6L	31
G 30	4	Weld-in socket DN25 - G1/4" Escobal liquid Socket Inclined	A4179 3R6L	31
H 29	4	Plate 6 D=80x4=45	A240 3R6L	31
H 28	1	Bar D=70xH L=30	A4179 3R6L	31
D 27	3	Plate 4 35x7.5	A240 3R6L	31
C 26	1	Variant 1 Housing DN 80/65 see Process Connection	A4179 3R6L	31
C 25	1	Sightglass DN25 PN 10 acc. DWG 00-015	A4179 3R6L	31
C 24	1	Variant 1 Housing DN27/25 see Process Connection	A4179 3R6L	31
C 23	7	Variant Nozzle DN 50/40 acc. DWG 00-001	A4179 3R6L	31
A 22	1	WNER Flange 2" 50# ASME BR 5.5-277 Sm.Fm.	A482 3R6L	-
I 21	1	Gasket D=34-d=30x - 32 mm	EPDM	-
C 20	1	Forged ring D=102.4 A.M d=90.4 A.M H=72.4 A.M	A482 3R6L	31
C 19	1	Forged ring D=102.4 A.M d=90.4 A.M H=72.4 A.M	A482 3R6L	31
C 18	1	O-Ring DN50 DIN1984 - GFA supply	EDM	31
A 17	4	Nut M8 DIN934	A2 0UN267	-
A 16	8	Washer M8 DIN1234	A2	-
A 15	4	Bolt M8x35 DIN933	A2-70 0UN267	-
A 14	1	Blindflange DN50 DIN1984 - GFA supply	A482 3R6L	31
A 13	1	Pipe Welded D=60.3x2.77 L=120	A320 P3R6L	31
I 12	1	Plate 4.5 D=35x4=20	A240 3R6L	31
D 10	1	Pipe Welded D=42.2x2.77 L=25	A320 P3R6L	31
A 9	1	Elbow D=21.3x2.11 45°-LR	A403W 3R6L	31
D 8	1	Plate 4 92x20	A240 3R6L	31
A 7	1	Pipe Welded D=21.3x2.11 L=1982	A320 P3R6L	31
4	1	WNER Flange 3" 50# ASME BR 5.5-54.9	A482 3R6L	31
3	1	Pipe Welded D=88.9x5.49 L=47	A320 P3R6L	31
A 2	4	Flange DN50 DIN1984 - GFA supply	A482 3R6L	31
A 1	4	Pipe Welded D=60.3x3.55 L=57	A320 P3R6L	31

Detail N24

NO.	DESCRIPTION	QTY	UNIT	REVISION
H 34	1	Plate 6 D=80x4=26	A240 3R6L	31
H 33	1	ExH Weld-in Thermowell Ø25	A4179 3R6L	31
G 32	1	Sample nozzle Keuffler Valve body W9 type T	A4179 3R6L	31
H 31	1	Plate 6 D=80x4=29	A240 3R6L	31
G 30	4	Weld-in socket DN25 - G1/4" Escobal liquid Socket Inclined	A4179 3R6L	31
H 29	4	Plate 6 D=80x4=45	A240 3R6L	31
H 28	1	Bar D=70xH L=30	A4179 3R6L	31
D 27	3	Plate 4 35x7.5	A240 3R6L	31
C 26	1	Variant 1 Housing DN 80/65 see Process Connection	A4179 3R6L	31
C 25	1	Sightglass DN25 PN 10 acc. DWG 00-015	A4179 3R6L	31
C 24	1	Variant 1 Housing DN27/25 see Process Connection	A4179 3R6L	31
C 23	7	Variant Nozzle DN 50/40 acc. DWG 00-001	A4179 3R6L	31
A 22	1	WNER Flange 2" 50# ASME BR 5.5-277 Sm.Fm.	A482 3R6L	-
I 21	1	Gasket D=34-d=30x - 32 mm	EPDM	-
C 20	1	Forged ring D=102.4 A.M d=90.4 A.M H=72.4 A.M	A482 3R6L	31
C 19	1	Forged ring D=102.4 A.M d=90.4 A.M H=72.4 A.M	A482 3R6L	31
C 18	1	O-Ring DN50 DIN1984 - GFA supply	EDM	31
A 17	4	Nut M8 DIN934	A2 0UN267	-
A 16	8	Washer M8 DIN1234	A2	-
A 15	4	Bolt M8x35 DIN933	A2-70 0UN267	-
A 14	1	Blindflange DN50 DIN1984 - GFA supply	A482 3R6L	31
A 13	1	Pipe Welded D=60.3x2.77 L=120	A320 P3R6L	31
I 12	1	Plate 4.5 D=35x4=20	A240 3R6L	31
D 10	1	Pipe Welded D=42.2x2.77 L=25	A320 P3R6L	31
A 9	1	Elbow D=21.3x2.11 45°-LR	A403W 3R6L	31
D 8	1	Plate 4 92x20	A240 3R6L	31
A 7	1	Pipe Welded D=21.3x2.11 L=1982	A320 P3R6L	31
4	1	WNER Flange 3" 50# ASME BR 5.5-54.9	A482 3R6L	31
3	1	Pipe Welded D=88.9x5.49 L=47	A320 P3R6L	31
A 2	4	Flange DN50 DIN1984 - GFA supply	A482 3R6L	31
A 1	4	Pipe Welded D=60.3x3.55 L=57	A320 P3R6L	31


AS BUILT: [] STATUS: NSP AUTHORITY: []
 STATUTS: FB [] STATUTS CLIENT: []
 SCALE: 1:5 DATE: 02-06-2009
 DRAWN: A. Heesters
 CHECKED: G. Blijker
 PROJECT: GEA Process Engineering Nederland BV
 BP - ZA 7067 D15141
 SUBJECT: Medium Seed Fermentor YA - V3301
 Nozzle detail

FB Industriële bedrijven
 POSTBUS 314
 8912 AP LEEUWARDEN
 TEL: 058 284 59 45
 FAX: 058 283 51 42
 engineer@fb.nl



REVISION: AH, 22-02-2010, see rev. marks.
 RV, 04-03-2010, see rev. marks.
 AH, 11-03-2010, see rev. marks.
 AH, 24-03-2010, see rev. marks.

A1
 REG. NO. 202311
 15-003

This document is a confidential document. No value or any part of this document may be disclosed to any third party or reproduced in any form without the written consent of FB Industriële bedrijven.

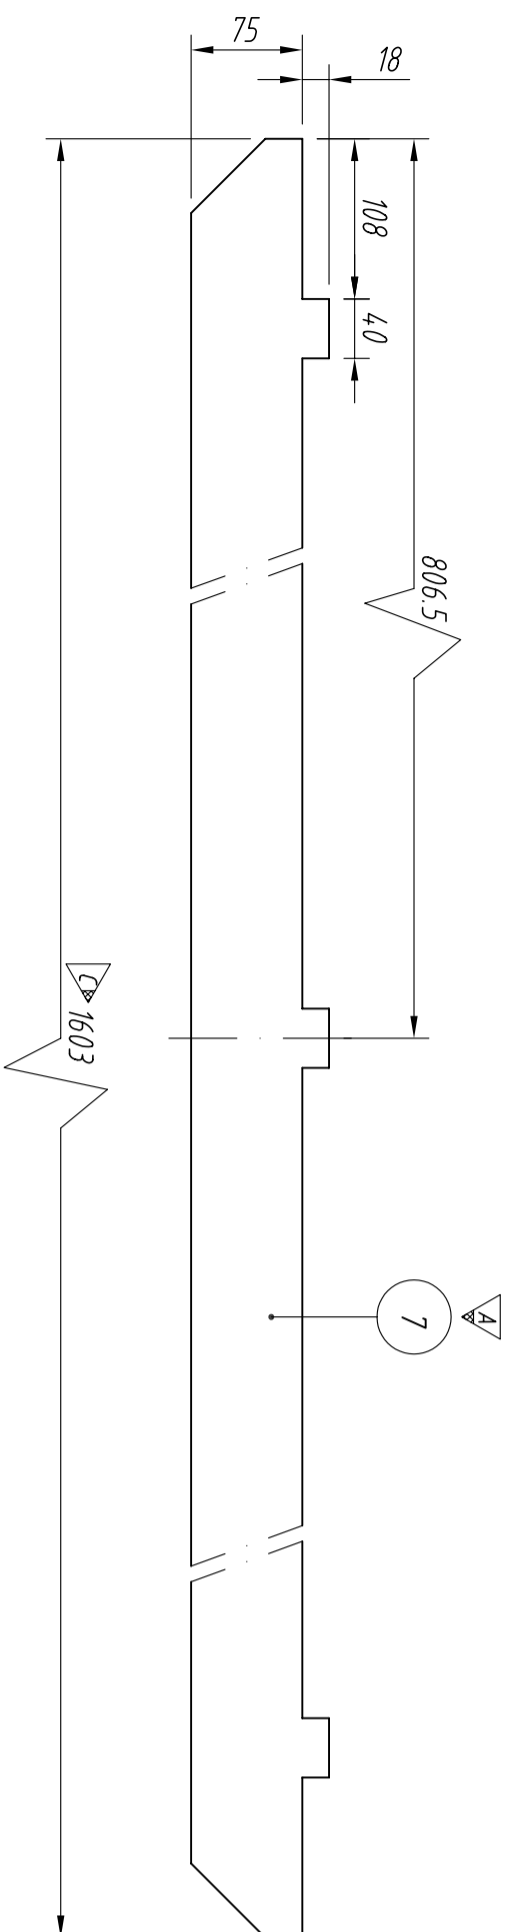

Detail Baffle position 30°, 120°, 210° & 300°

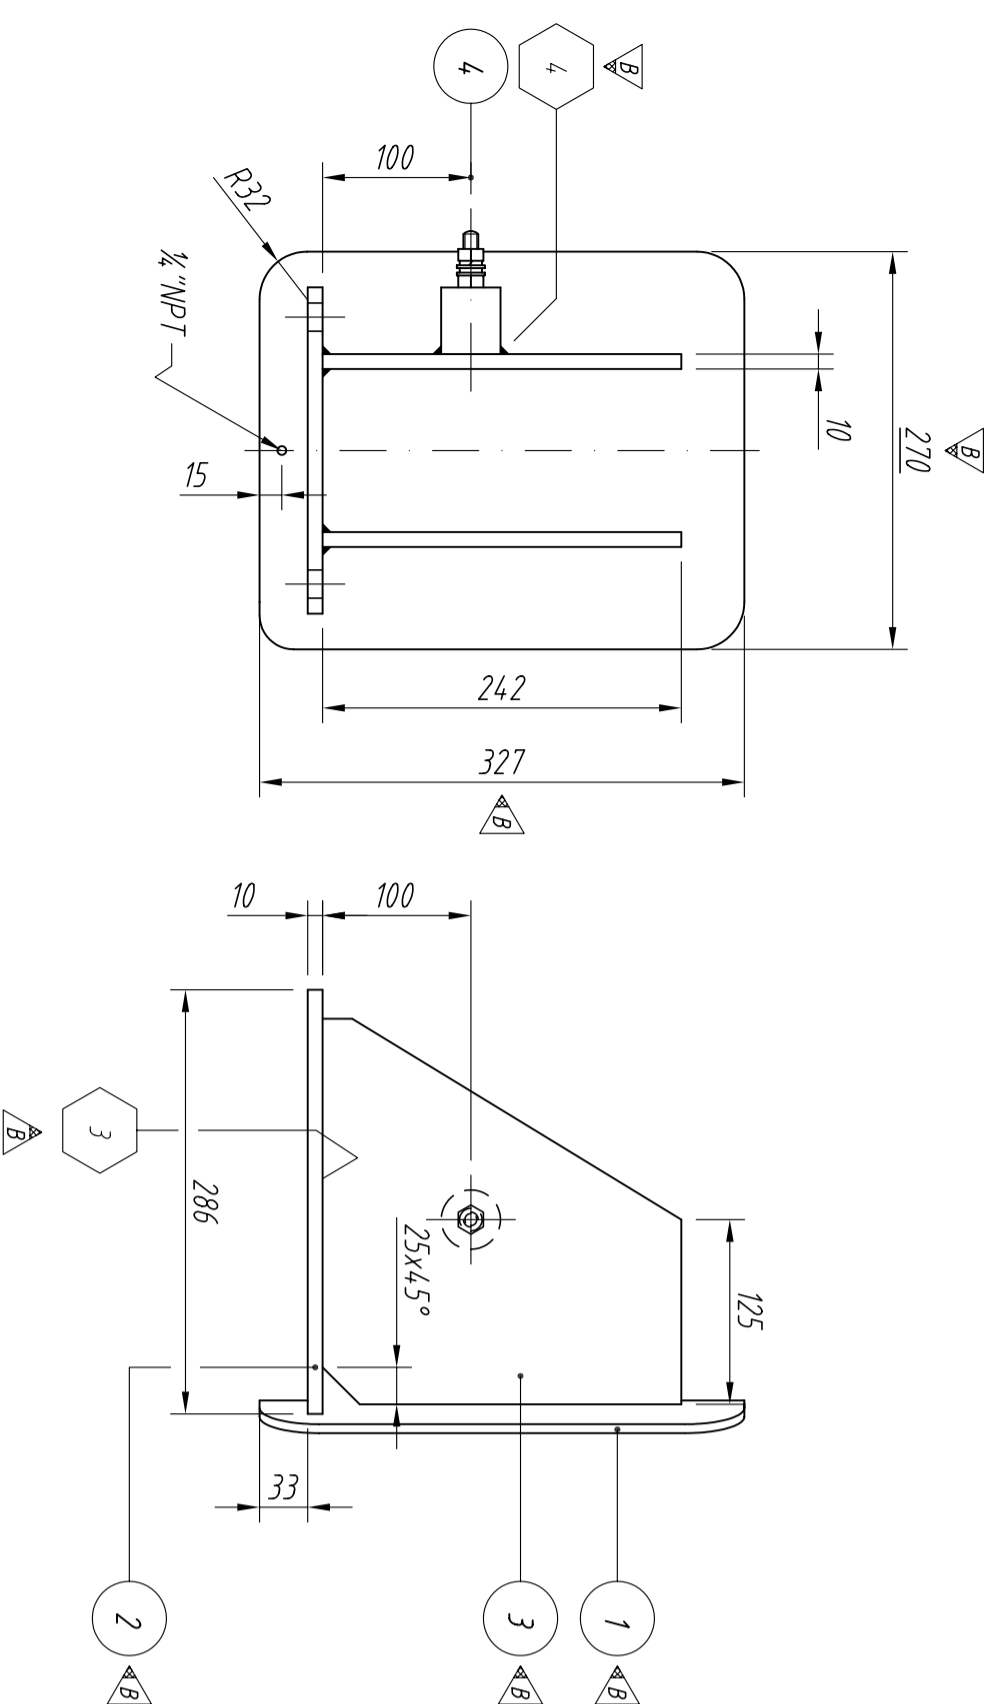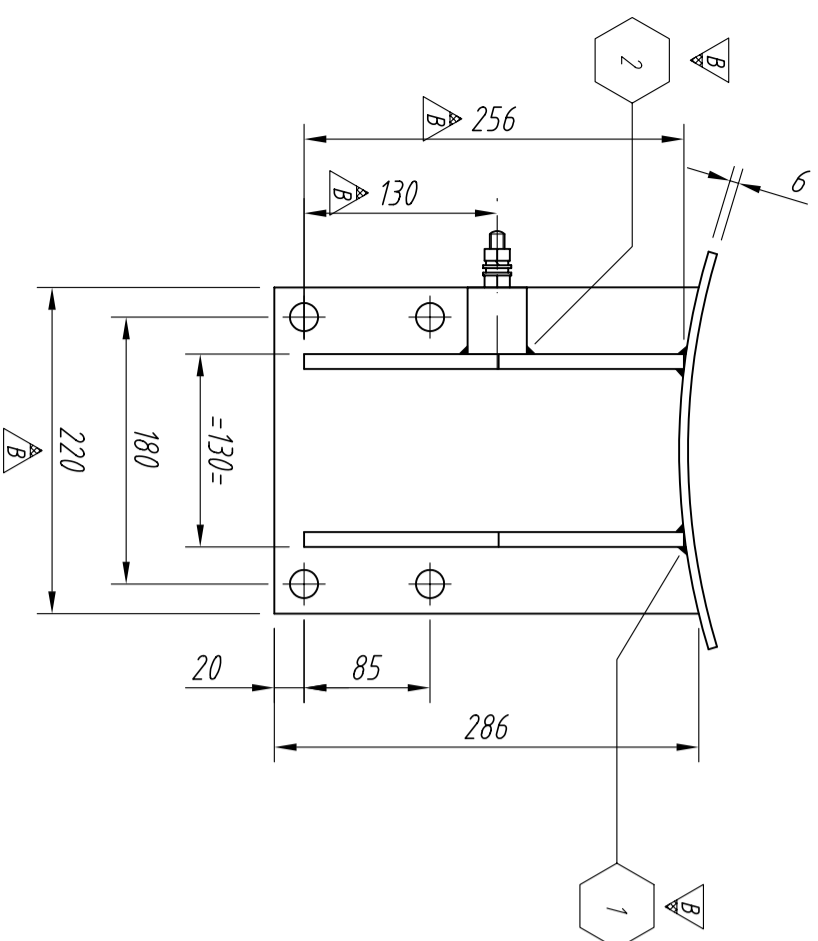

Detail Bracket DN28083 Size 4

All welds $\Delta a = 0.7xt$
Unless other wise noted

ITEM NO.	DESCRIPTION / DIMENSION	MATERIAL	QTY
B 1	Plate 10 1603x93	A240 316L	3 1
C 4	Earthingboss	SS / Brass	-
C 3	Plate 10 256x212	A240 304L	3 1
B 2	Plate 10 286x220	A240 304L	3 1
B 1	Plate 6 327x270	A240 316L	3 1

SCALE	DATE	REMARKS
1:5	02-06-2009	-
DRAWN	K vd Haring	-
CHECKED	G. Bijker	20-01-2010

PROJECT	SUBJECT
GEA Process Engineering Nederland BV BP - ZA 7067 - D15141	Medium Seed Fermentor YA - V3301 Bracket / lugs

FORM	REVISION
A2	15-004

This document is confidential. Neither the whole or any part of this document may be disclosed to any third party or reproduced in any form without written consent of FIB Industriële Bedrijven bv