

Mechanical data		Vessel	
Design code	ASME VIII div.1 ed. 2007 add. 2008 / PED Cat. IV module H1		
Inspection	FIB QA		
Design pressure Max. / Min.	3 / -1	-	-
Design temperature Max. / Min.	135 / 0	-	-
Operating pressure Max. / Min.	2 / -1	-	-
Operating temperature	120 / 10	-	-
Test pressure (Horz.)	4.82	-	-
Volume	10	-	-
Corrosion allowance	0	-	-
Joint efficiency	0.85 acc. uw 12 (b)	-	-
X-ray	Spot acc. uw 11 (b)	-	-
Corrosion	PED Fluidgroup / Phase	-	-
Weight empty (incl. 120 Kg Insulation)	1700	-	-
Weight full of water	11700	-	-
Welding method	See WPS		
Surface treatment	SS: see note 3		
	CS: -		
Tolerances according	FIB-TOL-002		
Flange gasket contact face finish	Smooth finish (Ra 3.2-6.3 µm)		
Bolt holes in the flanges to straddle centerlines unless otherwise shown on dwg			

Process connection				
Mark	Numb. Req.	Service	Nom. Bore	Pipe
N1	1	Product Outlet Bottom	DN50	-
N2	1	CIP	DN80/65	-
N3	1	Product Inlet Top	DN50	-
N4	1	Acid	DN32/25	-
N5	1	Caustic	DN32/25	-
N6	1	CO2 / Process air	DN80/65	-
N7	1	CIP/ Water	DN80/65	-
N8	1	Spray Nozzle 1	DN125	14.1x8.56
N9	1	Agitator connection	DN4.00	PAD Flange
N10	1	Spraynozzle 2	DN125	14.1x8.56
N11	1	Pressure transmitter	DN50/40	-
N13	1	Sightglass / lightglass	DN200	-
N14	1	Grain Inlet Top	8"	219x8.18
N15	1	Bursting Disk	DN25	-
N16	1	Levelswitch Top	DN50/40	-
N17	1	pH Transmitter1	DN50/40	-
N18	1	Temperatuur transmitter	DN50/40	-
N19	1	pH Transmitter 2	DN50/40	-
N20	1	Bursting disk upside down	DN65	-
N21	1	Levelswitch Bottom	DN50/40	-
N23	1	Extra Sprayball Conn.	DN100	-

Other connection				
Mark	Numb. Req.	Service	Nom. Bore	Pipe
M1	1	Manhole	DN500	-
N22	3	Weight transmitter	-	-


Reference document list		
Document no.	Document name	Client document no.
00-009	Manhole 500x25 with sightglass DN200	-
221MBL002243G-3	Varivent T Housing	-
05-003	Nozzle details	-
05-004	Bracket details	-
05-200	Strength Calculations	-
05-250	WPS	-
05-252	PQR	-
05-298	Risk Analysis	-
05-600	Installation Manual	-
05-900	Test & Inspection plan	-
M.A.P. III	Mechanical Assurance Practise	-
ZA 7	Process data sheet	-

General notes	
1	Build up: Rockwool & Aluminiumplate.
2	All main pressure bearing parts 3.1 cert. EN10204 acc. PED annex 1 Par. 4.3
3	Finish outside, Pickled and passivated surface finish inside; 2B < Ra 0.8um welding finish inside; Ra < 0.8 µm
5	Flange N9 "Agitator connection" Machining after welding
6	Nameplate acc.: GIS-46-0101 section 7.11.3
7	Earthingbosses acc.: GIS-46-0101 section 7.11.5
8	All sharp edges inside to be rounded off with R=5
9	For all DIN 11864 nozzles the grooved flange is welded on the vessel.
10	There are to be no underflush weld caps
11	Only materials from a European or North-American origin will be used
12	100% DPI of support and lifting attachment welds
13	Refer to aseptic project specification. (BD 2007)
14	Manhole to be provided with at least 1 locking nut


REF. POS. NO.	NUMB. REQ.	DESCRIPTION / DIMENSION	MATERIAL	CERT.
H 7	1	Plate 2 D=1037 d=1007 h=48 (Cone)	A240 316L	3.1
D 6	2	Flatbar 80x8 L=5755	ANSI 316L	3.1
A 5	1	Plate 3 330x160	A240 304L	3.1
H 4	1	Nameplate 2 180x140	SS	-
	3	Plate 6 1712x5485	A240 316L	3.1
	2	Plate 6 2000x5485	A240 316L	3.1
G 1	2	Head HD ID=1740 h=25 t=7.8 Min. A.F. Acc. DIN28011	A240 316L	3.1

AS BUILT STATUS FIB	AS BUILT STATUS CLIENT	AS BUILT STATUS INSP. AUTHORITY
E	F	G
SCALE 1:15		
DATE 15-05-2009	REMARKS	
DRAWN A.Hoekstra	Drawing acc. GEA datasheet YA-V201 Rev. H	
CHECKED G.Bijker	14-04-2010	
PROJECT GEA Process Engineering Nederland BV BP - ZA 7034 - D15133		
SUBJECT Large Saccharifier - YA - V201 General Arrangement		
FIB industriële bedrijven		
EINSTEINWEG 18 8912 AP LEEUWARDEN	POSTBUS 314 8901 BC LEEUWARDEN	TEL. 058 294 59 45 FAX 058 212 57 42
www.fib.nl engineering@fib.nl	FORM A1	REG. NO. - DRAWING NO. 730311
SHEET NO. 05-001		REVISED AH, 18-05-2009, see rev. marks G, 15-10-2009, see rev. marks H, 27-11-2009, see rev. marks I, 25-03-2010, see rev. marks J, 14-04-2010, see rev. marks


This document is confidential. Neither the whole or any part of this document may be disclosed to any third party or reproduced in any form without written consent of FIB Industriële Bedrijven.

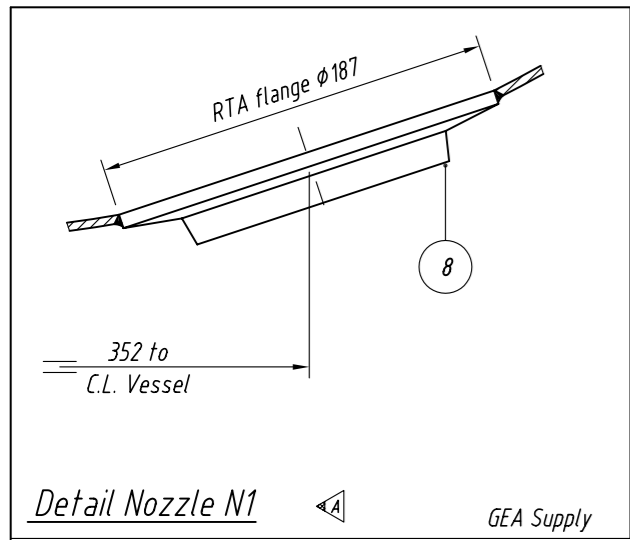


Detail Nozzle N1 GEA Supply

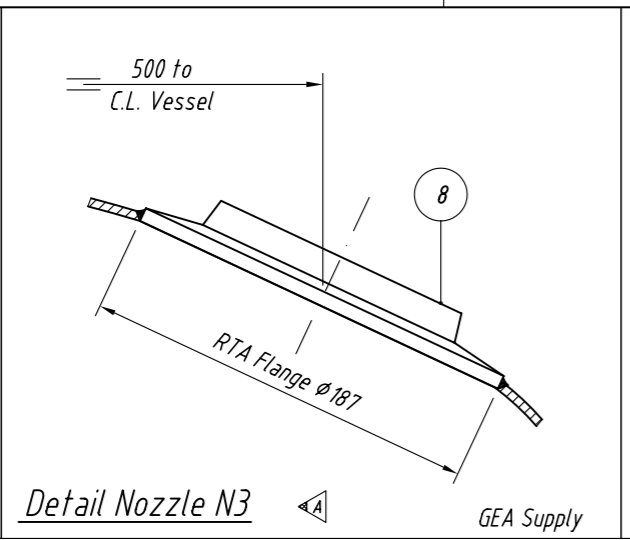


Detail Nozzle N3 GEA Supply

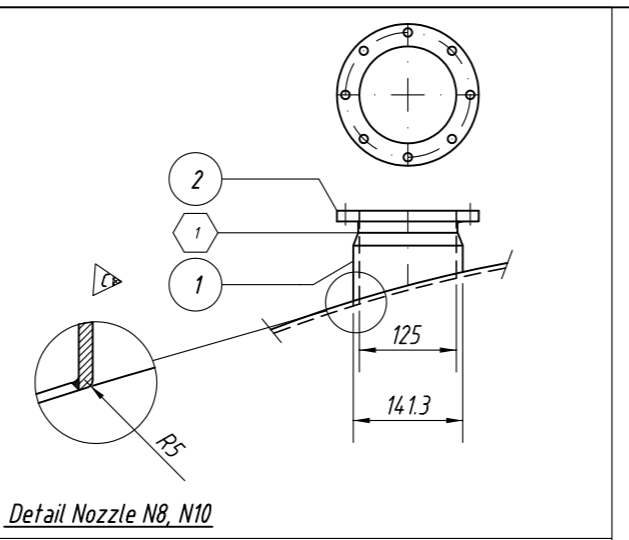


Detail Nozzle N8, N10

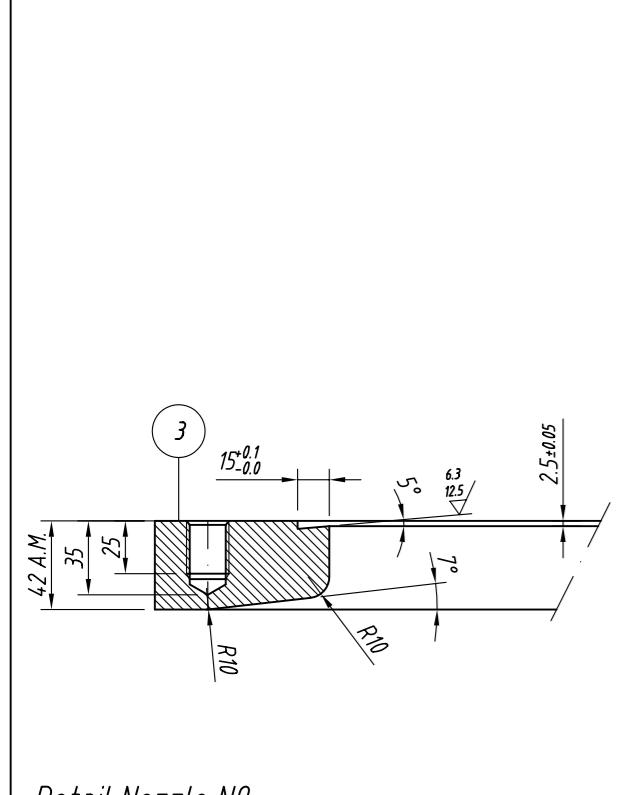


Detail Nozzle N9

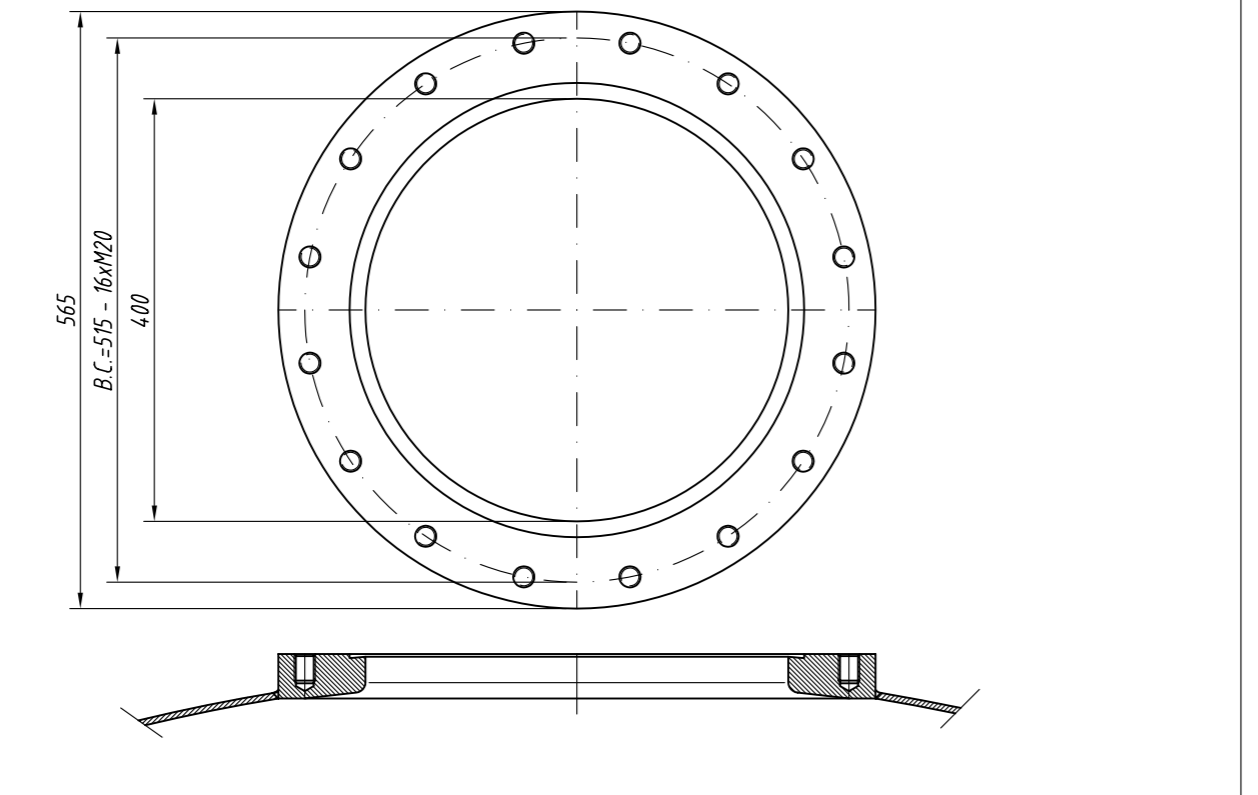


Detail Insulation ring

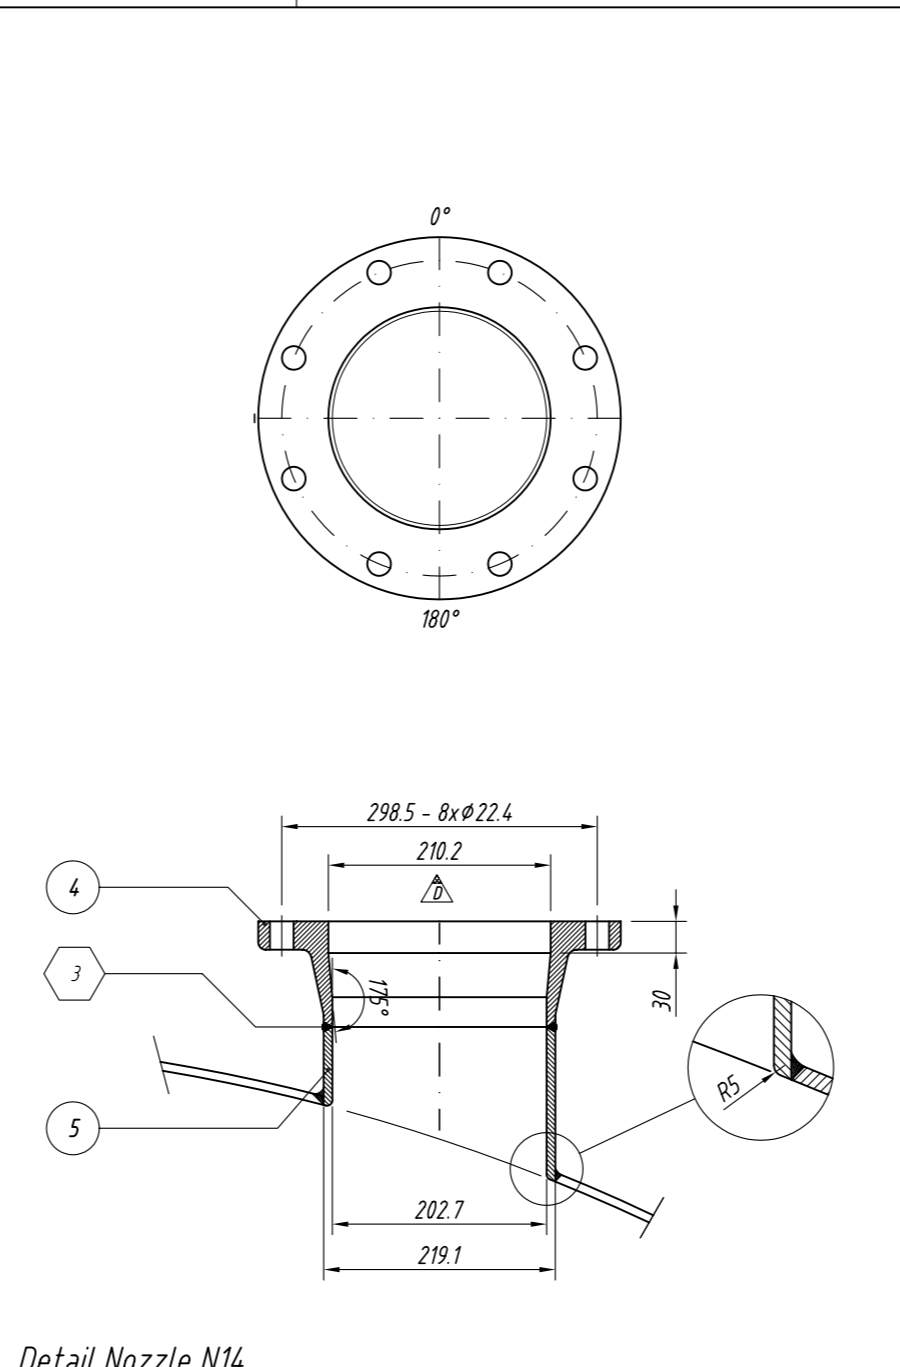


Detail Nozzle N14

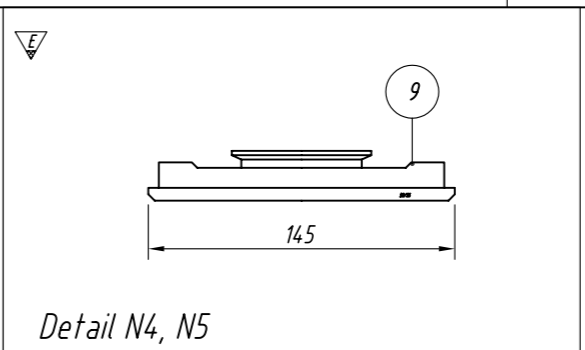


Detail N4, N5

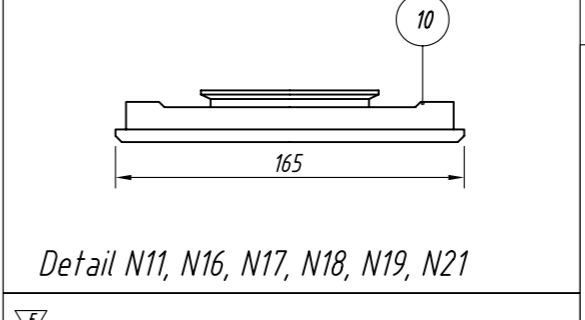


Detail N11, N16, N17, N18, N19, N21

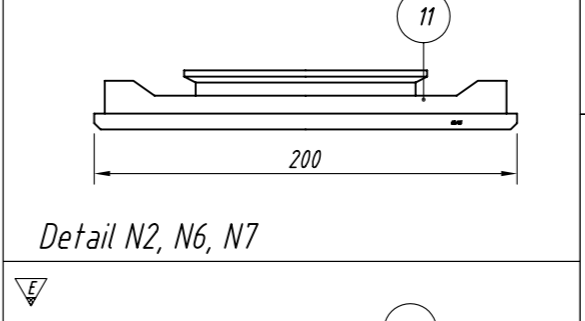


Detail N2, N6, N7

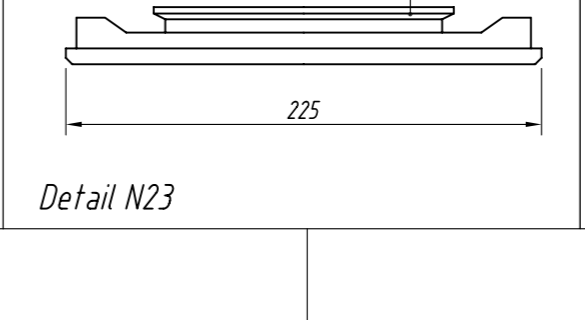


Detail N23

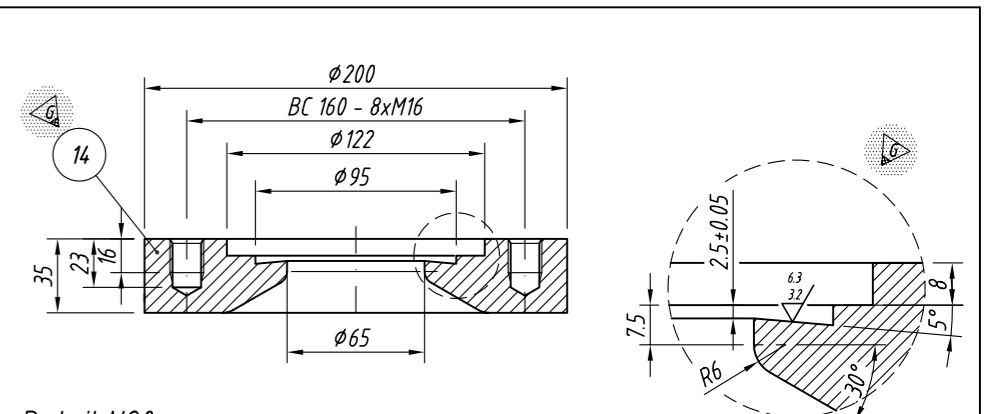


Detail N20

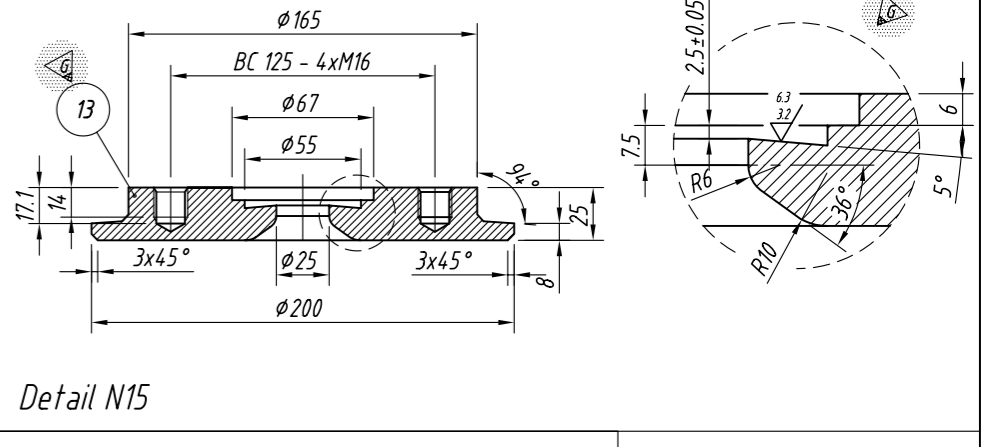


Detail N15

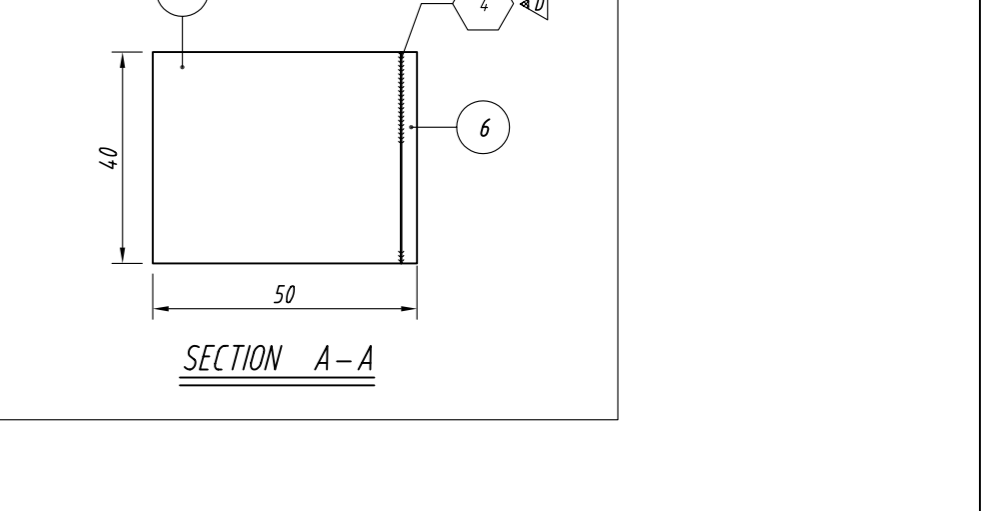

SECTION A-A

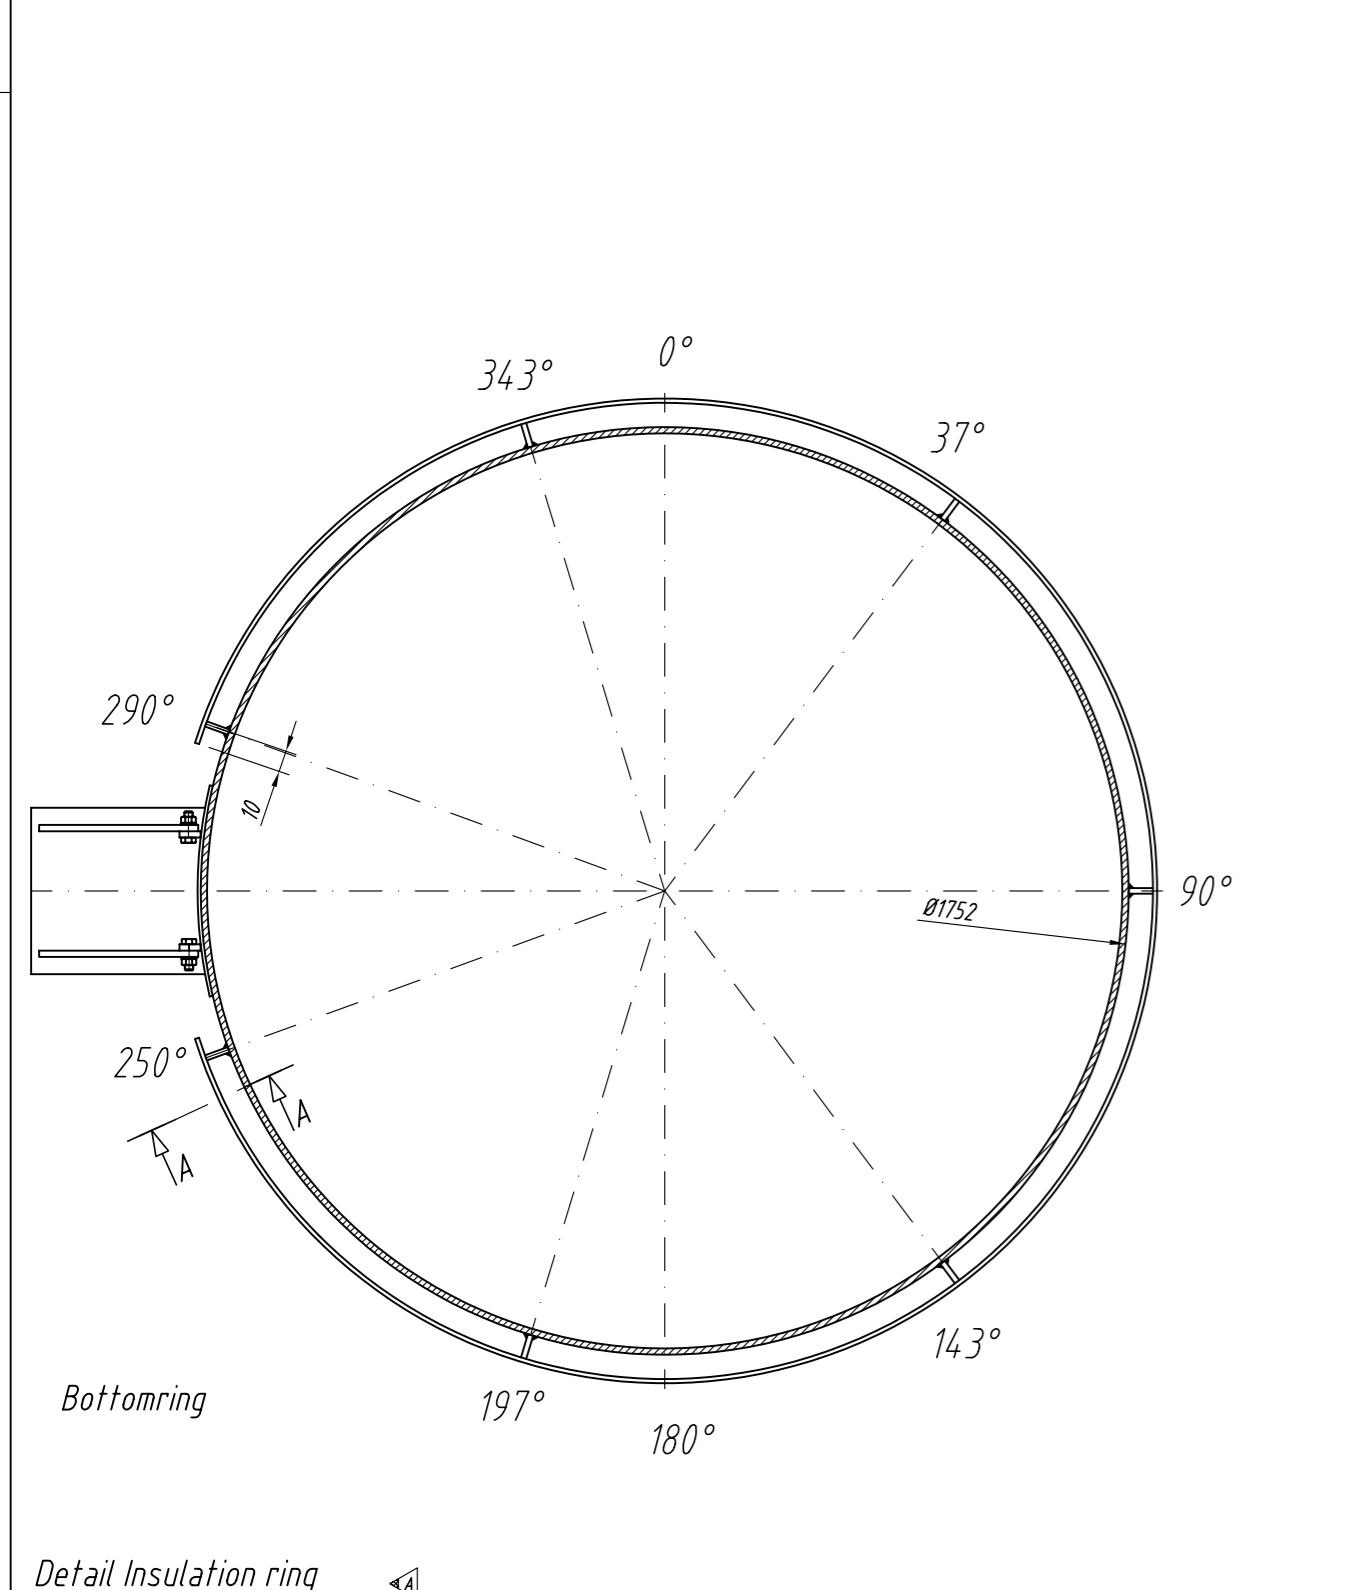

Detail Bottomring

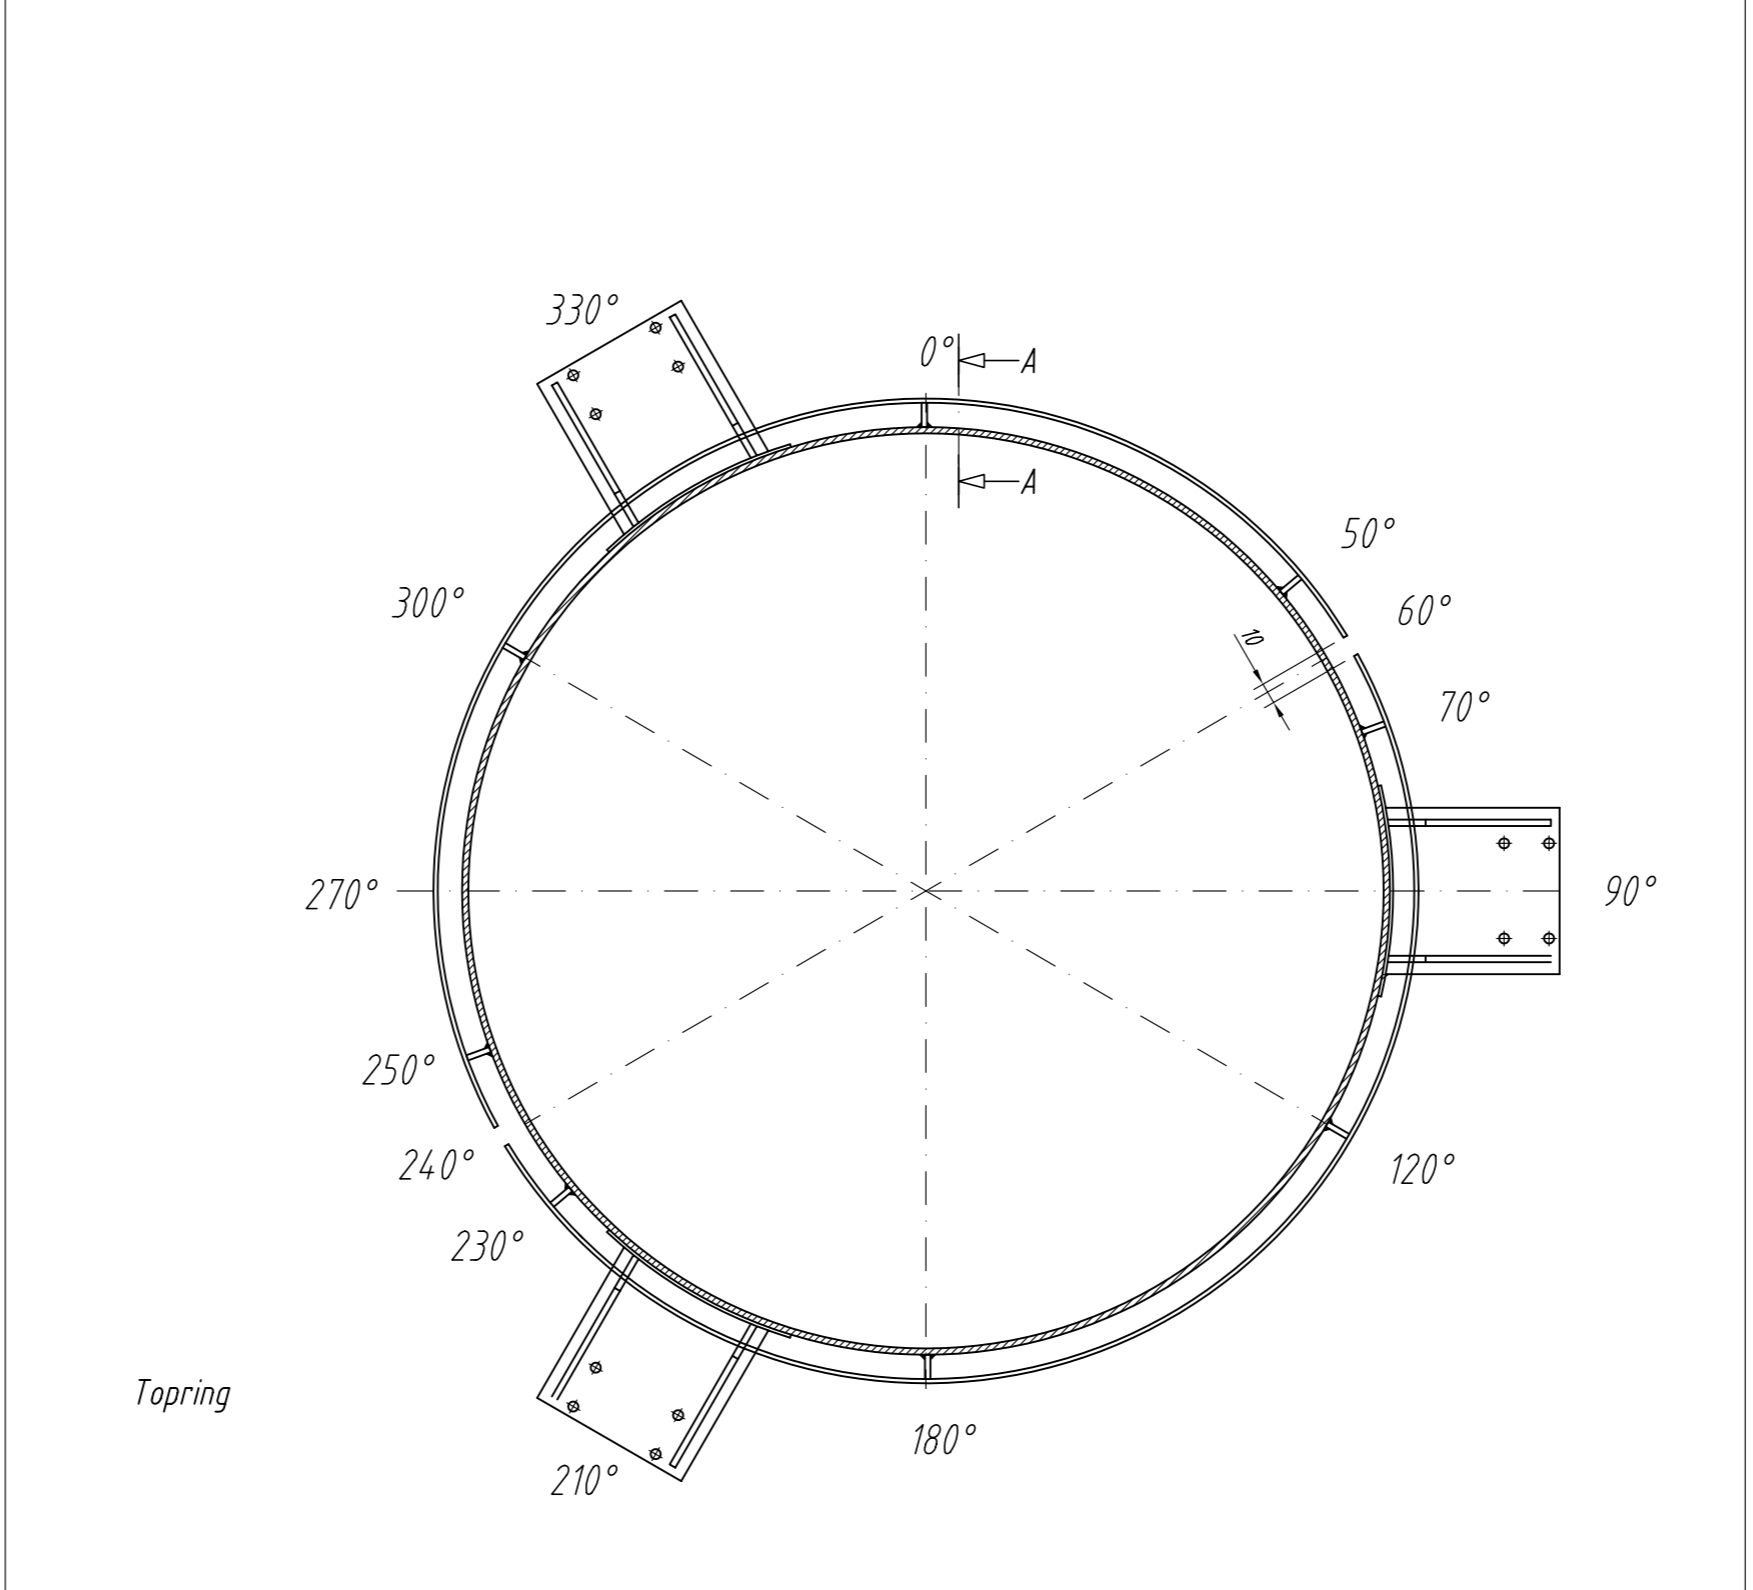

Detail Topring

NO.	QTY	DESCRIPTION / DIMENSION	MATERIAL	CERT.
G 14	1	Plate 25 D=200	A240 316L	3.1
G 13	1	Plate 25 D=165	A240 316L	3.1
E 02	1	Varietent Housing DN 100 see Process Connection	A479 316L	3.1
E 11	2	Varietent T Housing DN 80/65 see Process Connection	A479 316L	3.1
E 10	6	Varietent T Housing DN 50/40 see Process Connection	A479 316L	3.1
E 9	2	Varietent T Housing DN 32/25 see Process Connection	A479 316L	3.1
E 8	2	Flange RTA DN50 PN6 see Process Connection	A479 316L	3.1
E 7	15	Flange DN 40x4 L=46	A240 304L	3.1
E 6	2	Flange DN 40x4 L=5830	A240 304L	-
S 1	1	Pipe Welded D=219 InR 18 L=147	A302TP316L	3.1
4	1	WNFF Flange 8" 150# ASME B16.5 s=8.18	A182F316L	3.1
3	1	Plate 45 D=565 d=400	A240 316L	3.1
A 2	2	Flange DN 125 DN11864 - GEA supply	A182F316L	3.1
E 1	2	Bar D=140 L=95	A490 316L	3.1





AS BUILT	AS BUILT	AS BUILT	AS BUILT
STATUS FIB	STATUS CLIENT	STATUS INSP.	AUTHORITY
E	F	G	H


SCALE	DATE	REVISIONS
1:5	02-06-2009	-




PROJECT	DRAWING NO.	SHEET NO.
GEA Process Engineering Nederland BV BP - ZA 7034	730311-05	05-003



Detail Bracket DIN28083 Size 6

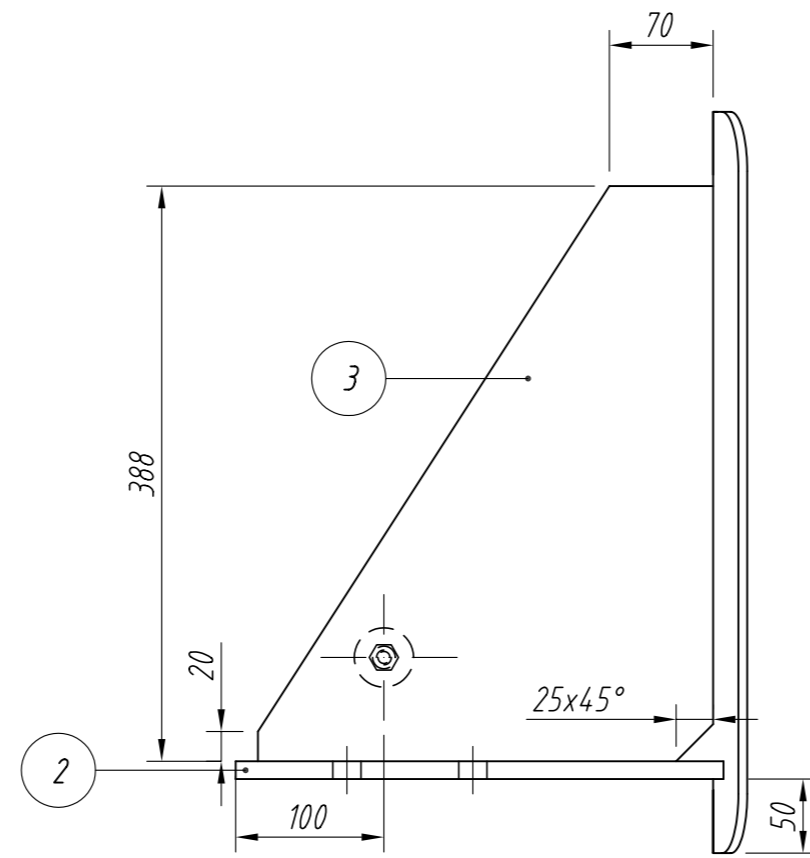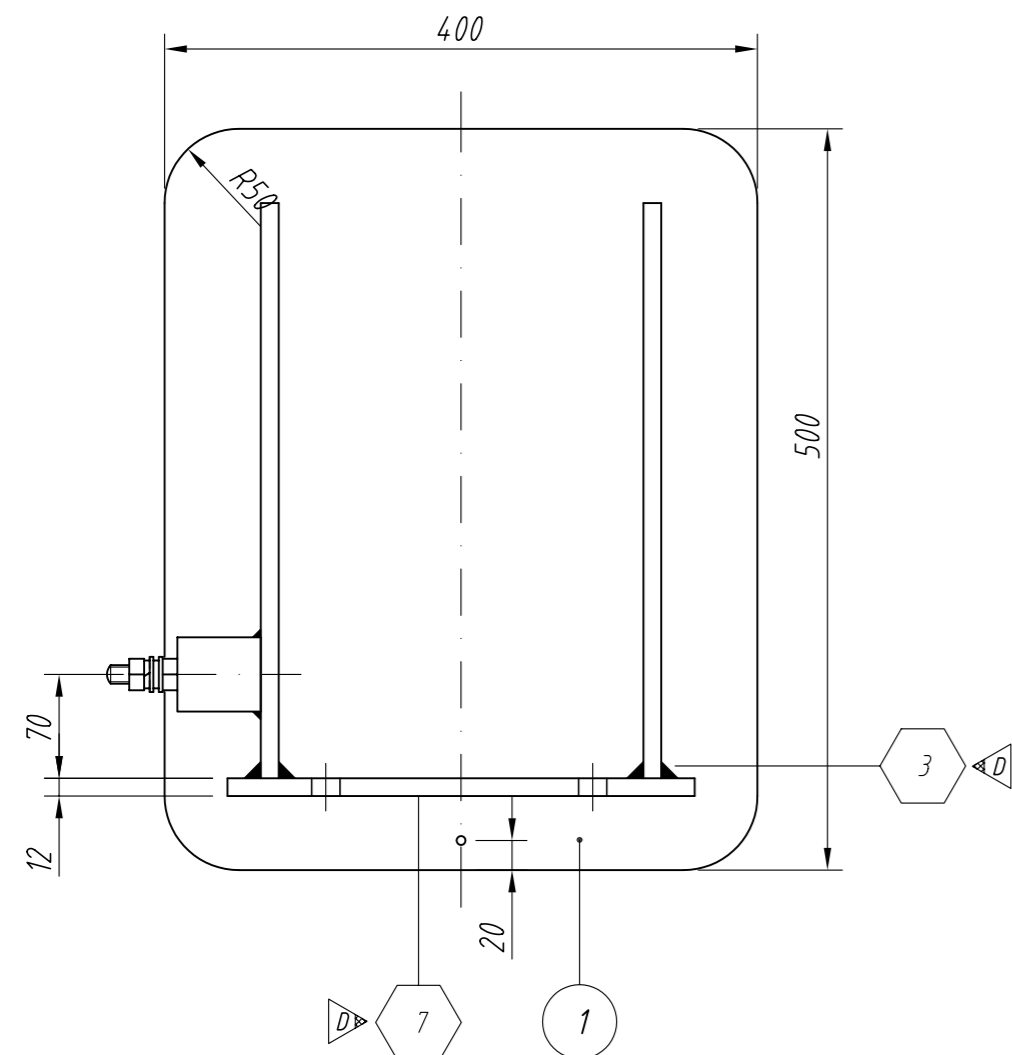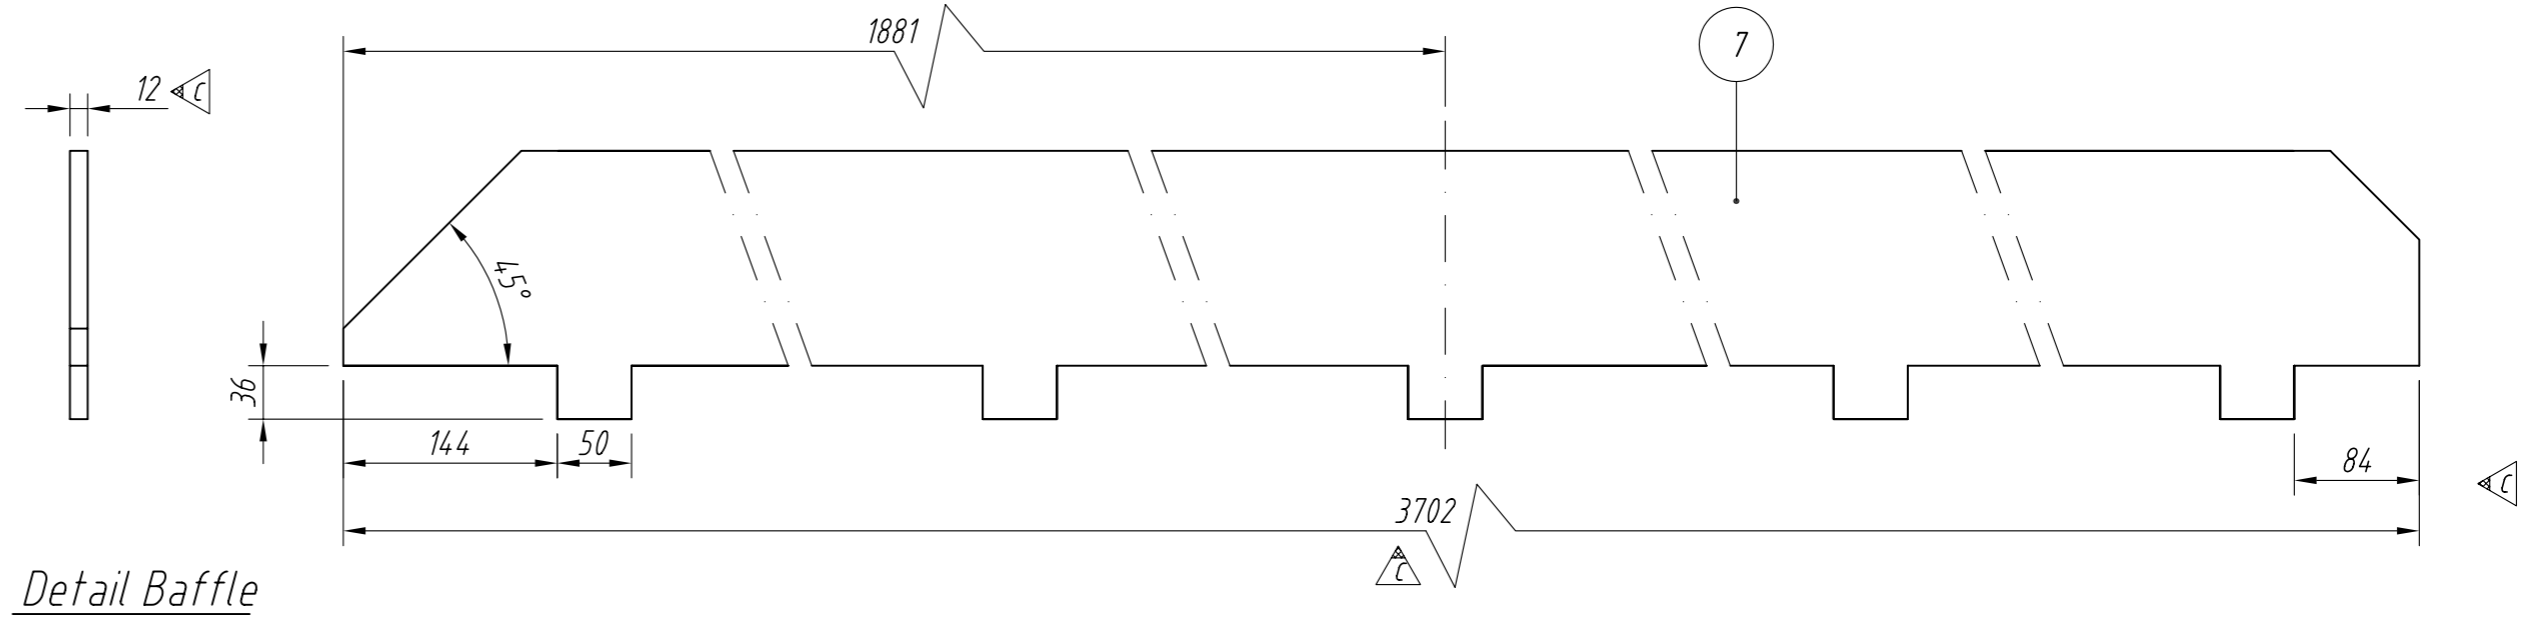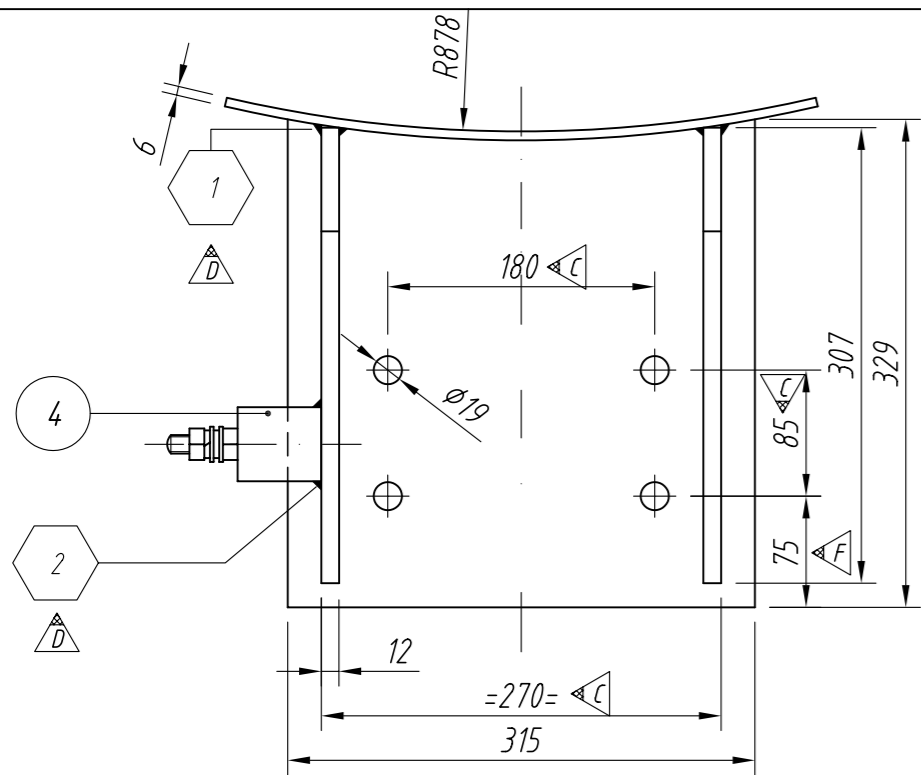

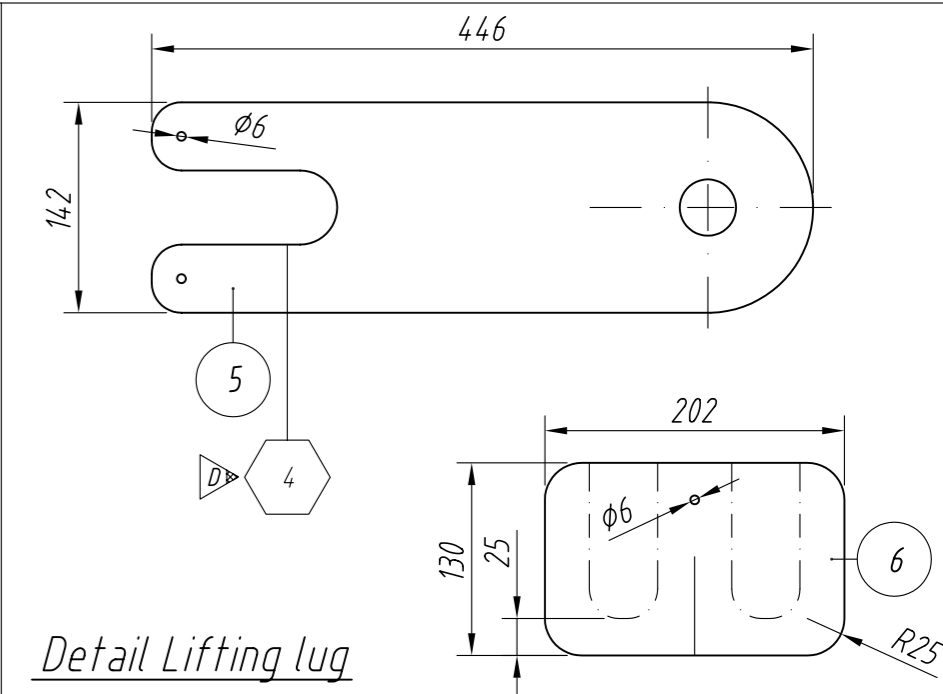Detail Lifting Lug

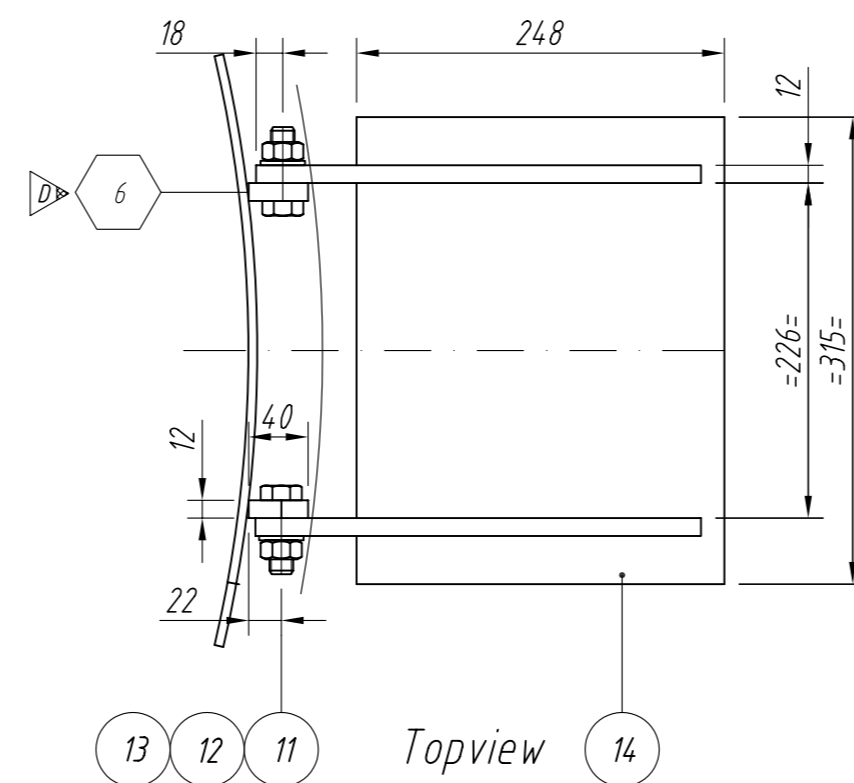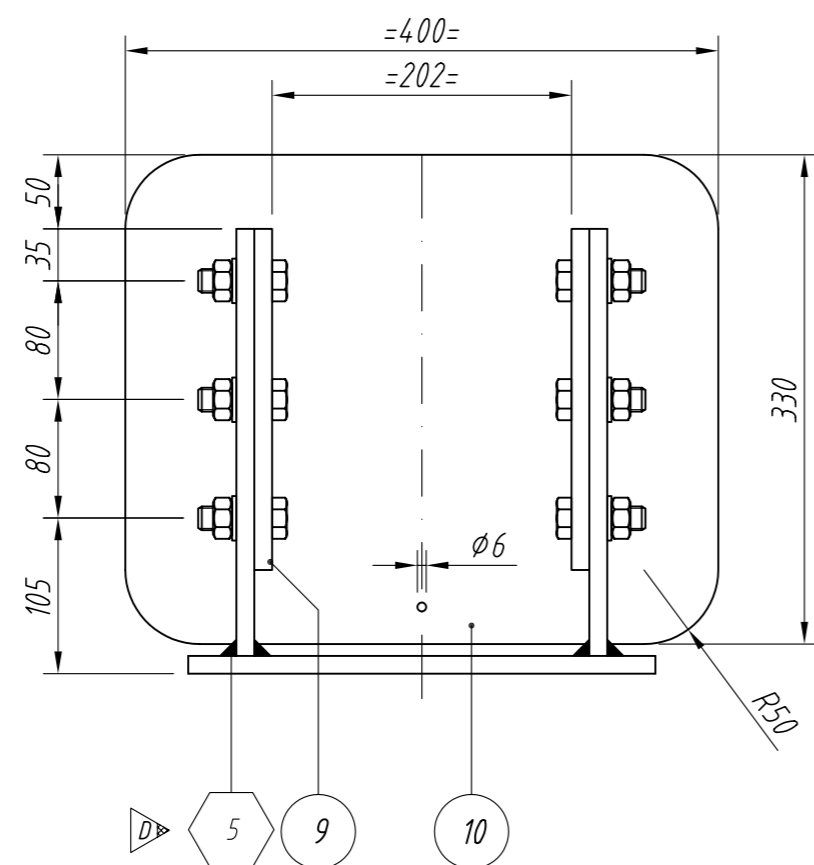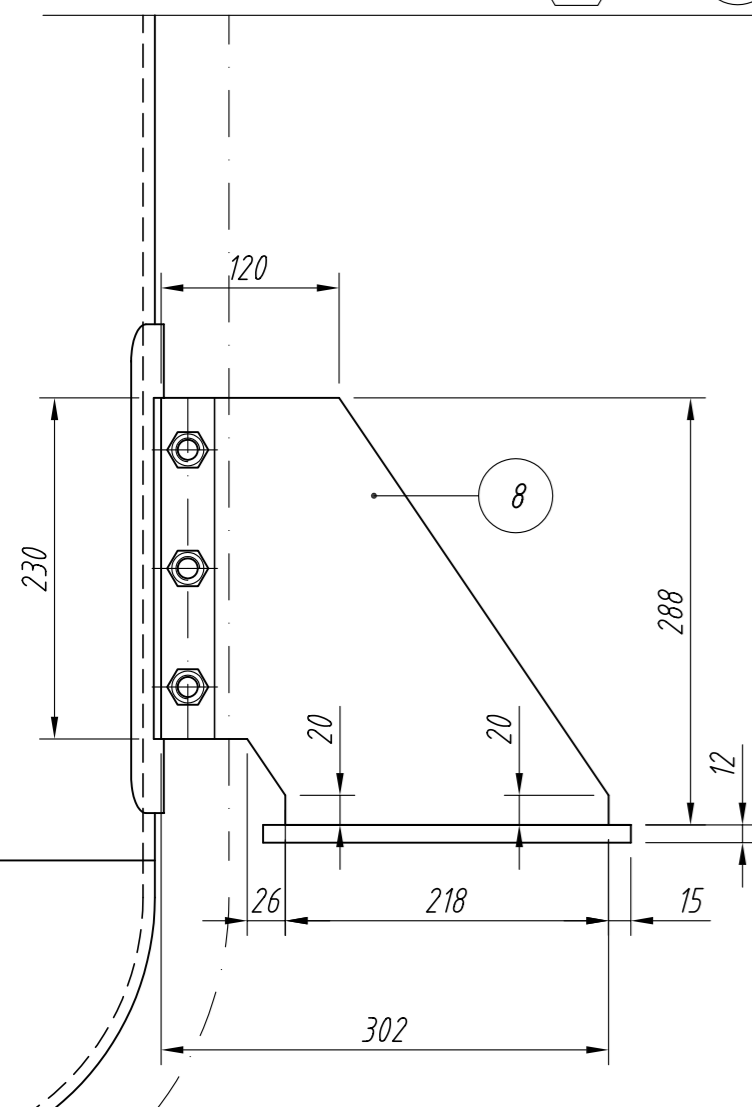

REV	POS	NUMB	DESCRIPTION / DIMENSION	MATERIAL	CERT.
C	14	1	Plate 12 248x315	A240 316L	-
C	13	6	Washer M16 DIN125A	A4	-
C	12	6	Nut M16 DIN934	A4 DIN267	-
C	11	6	Bolt M16x50 DIN933	A4-70 DIN267	-
C	10	1	Plate 6 400x330	A240 316L	3.1
C	9	2	Plate 12 40x230	A240 304L	-
C	8	2	Plate 12 302x288	A240 304L	-
C	7	4	Plate 12 3702x181	A240 316L	3.1
6	2	2	Plate 6 202x130	A240 316L	3.1
5	2	2	Plate 15 446x142	A240 304L	-
4	2	2	Earthingboss	SS / brass	-
C	3	6	Plate 12 307x388	A240 304L	-
C	2	3	Plate 12 329x315	A240 304L	-
C	1	3	Plate 6 500x402	A240 316L	3.1

REV	POS	NUMB	DESCRIPTION / DIMENSION	MATERIAL	CERT.		
AS BUILT	STATUS FIB			AS BUILT	STATUS CLIENT	AS BUILT	STATUS INSP. AUTHORITY
E	F	G	H	I	J		
SCALE	1:5	DATE	03-06-2009	REMARKS	-		
DRAWN	K vd Haring		20-01-2010				
CHECKED	G. Bijker		20-01-2010				
PROJECT: GEA Process Engineering Nederland BV BP - ZA 7034							
SUBJECT: Large Saccharifier - YA - V201 Bracket / lug							
FORM: A2				REG. NO. - DRWG. NO. 730311			
SHEET NO. 05-004							

FIB industriële bedrijven  
EINSTEINWEG 18 8912 AP LEEUWARDEN POSTBUS 314 8901 BC LEEUWARDEN TEL. 058 294 59 45 FAX 058 212 57 42 www.fib.nl engineering@fib.nl